

**SURVEY &
REMONUMENTATION**

APR 29 1995

COMMISSION

LAND CORNER RECORDATION CERTIFICATE

Filing Requirement of Act 74, Mich. P.A. 1970

JUDITH D. ROEHM
Ontonagon County
LC 3/290 JEM Fee: 9.00
Page 1 of 1

For corners in

ONTONAGON
(County)

Located In:

Corner Code #

- | | | | | | |
|---|---|-----------|---|-----------|------------|
| 1. Public Land Survey | T | <u>48</u> | R | <u>41</u> | <u>E-4</u> |
| | T | | R | | |
| | T | | R | | |
| | T | | R | | |
| 2. Property Controlling
in Section | S | | T | | R |
| | S | | T | | R |
| 3. Miscellaneous
Property in Section | S | | T | | R |
| | S | | T | | R |

Register of Deeds Stamp & File Number

4. Lot No. _____, Recorded Plat _____
5. Private Claims _____

$\frac{1}{4}$ Corner common to Sections 8 & 9, T48N R41W

I, Earl W. Applekamp, in a field survey on May 30, 19 95,
do hereby certify that under requirements of P.A. 74, Michigan P.A. of 1970, the corner points mentioned
in lines 1 and 2 above were in conformance with regulations and rules therefore as required in the current
manual of survey instructions of the United States Department of the Interior, Bureau of Land
Management or by a decree of a Court of Law and/or that the corner points mentioned in lines 3, 4 and
5 above were in conformance with the rules of the Michigan Board of Professional Surveyors or by a
Decree of a Court of Law; established, re-established, monumented, re-monumented, recovered, found
as expressed below:

**NOTE: Not more than 4 corners, all in the same town and range, may be recorded
on this certificate.**

	A	B	C	D	E	F	G	H	I	J	K	L	M
2	6			5		4		3		2			
3													
4	7			8		9		10		11		12	
5													
6	18			17		16		15		14		13	
7													
8	19			20		21		22		23		24	
9													
10	30			29		28		27		26		25	
11													
12	31			32		33		34		35		36	
13													

A. Description of original monument and accessories and/or subsequent restoration:

Corner established by Wills Burt, U.S. Deputy Surveyor, June 1851.
Set Post

Original Bearing Trees:


W. Birch	6"	N02°E	20 Links	(13.20 Feet)
Aspen	8"	East	13 Links	(8.58 Feet)

B. Description of corner evidence found and/or method applied in restoring or reestablishing corner:

No evidence of original corner or bearing trees were found. Corner position
is on a gravel road which has been in existence since early 1900. Corner
was established from existing fence lines going East and West and in the
centerline of a township road.. This corner was one of the corners remonu-
mented in a Block of 6 Sections in which all original corners were re-eslab-
lished. Research on file with the County Remonumentation Program Representative.

PEER GROUP APPROVED

Earl W. Applekamp 8-08-95
COUNTY REPRESENTATIVE

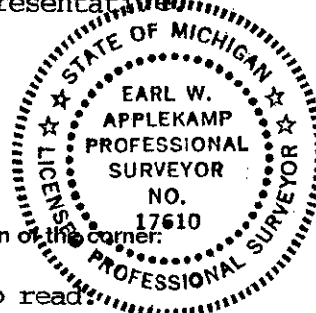

C. Description of monument for corner and accessories established to perpetuate locating the position of the corner:

At the corner I set a 3/4"x18" aluminum rod with a 3 1/4" cap stamped to read:
COUNTY REMONUMENTATION, $\frac{1}{4}$, S8, S9, T48N R41W, 1995, P.S. 17610. Monument
is 6" below top of gravel in the centerline of a Township road. A witness
monument was set and the cap is stamped the same as above. I established
the following witnesses:

Gas Sign Post	N12°W	112.91 feet	P. Pole	S16°W	118.92 feet
Nat. Gas M.P. 151	N18°E	91.05 feet	Witness corner West		34.83 feet

Signed by Earl W. Applekamp
Surveyor's Michigan License No. 17610

Date June 19, 1995