

SURVEY & REMONUMENTATION

APR 29 1996

COMMISSION

JUDITH D. ROEHM
Ontonagon County
LC 3/362 JEM Fee: 11.00
Page 1 of 2

LAND CORNER RECORDATION CERTIFICATE

Filing Requirement of Act 74, Mich. P.A. 1970

For corners in

<u>Ontonagon</u> (County)		Located In:	Corner Code <u>##</u>
1. Public Land Survey	Sec. 4	T <u>48N</u> R <u>42W</u>	<u>E-3</u>
		T <u> </u> R <u> </u>	<u> </u>
		T <u> </u> R <u> </u>	<u> </u>
		T <u> </u> R <u> </u>	<u> </u>
2. Property Controlling in Section	S <u> </u>	T <u> </u> R <u> </u>	<u> </u>
	S <u> </u>	T <u> </u> R <u> </u>	<u> </u>
3. Miscellaneous Property in Sec.	S <u> </u>	T <u> </u> R <u> </u>	<u> </u>
	S <u> </u>	T <u> </u> R <u> </u>	<u> </u>

Register of Deeds Stamp & File Number

4. Lot No. , Recorded Plat

5. Private Claims

One-quarter corner common to Sections 4 and 9, T48N, R42W

I, John R. Garske, in a field survey on September 28, 19 95, do hereby certify that under requirements of P.A. 74, Michigan P.A. of 1970, the corner points mentioned in lines 1 and 2 above were in conformance with regulations and rules therefore as required in the current manual of survey instructions of the United States Department of the Interior, Bureau of Land Management or by a decree of a Court of Law and/or that the corner points mentioned in lines 3, 4 and 5 above were in conformance with the rules of the Michigan Board of Land Surveyors or by a Decree of a Court of Law; established, re-established, monumented, re-monumented, recovered, found as expressed below:

NOTE: Not more than 4 corners, all in the same town and range, may be recorded on this certificate.

A. Description of original monument and accessories and/or subsequent restoration:

- On August 7, 1848, Austin Burt set a sugar post from which a 20" Y. birch bears S28°W, 17 links and a 18" lynn - N53°E, 24 links.
- 1915 - Plat of Valhalla indicates corner position.
- 1941 Michigan Department of Natural Resources survey by Greg Shadko, RLS, shows corner location along with witness monuments on north-south one-quarter line of Section 4.
- Keweenaw Land Association notes show corner position - no known date.

B. Description of corner evidence found and/or method applied in restoring or reestablishing corner:

Found Michigan Department of Natural Resources witness monuments as described above. From information received from Baraga MDNR Surveyor, Steve Szyskoski, RLS, using these found monuments in conjunction with copies of M.D.N.R. field notes, I was able to reestablish the corner position in the center of East Shore Road.

(Record Research on File)

(See Sketch on Back)

C. Description of monument for corner and accessories established to perpetuate locating the position of the corner:

Set a 3 1/4" diameter brass cap below pavement. Brass cap is stamped: County Remonumentation; T48N; R42W; 1/4; S-4; S-9; 1995; R.L.S. 28410, from which I established the following bearing trees and/or reference objects:


Found MDNR stamped witness monument - Due North - 16.50 feet - set a 6' steel rail with sign 1.10 feet north.
10" ash - S42°E - 56.00 feet
12" ash - S25°W - 59.76 feet

PEER GROUP APPROVED

Paul W. Appleton
COUNTY REPRESENTATIVE 10-18-95

Signed by John R. Garske
Surveyor's Michigan License No. 28410

Date 10-9-95

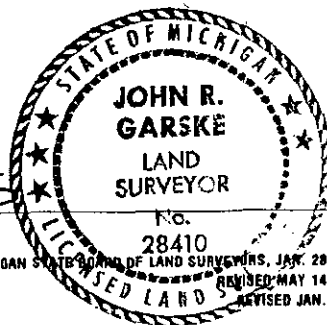

CFD No. E-11

362