

SURVEY &
REMONUMENTATION

APR 25 1995

LAND CORNER RECORDATION CERTIFICATE
Filing Requirement of Act 74, Mich. P.A. 1970

For corners in **COMMISSION**
Ontonagon
(County)

Located In:

Corner Code #

1. Public Land Survey T 48N R 42W
T R
T R
T R
T R
2. Property Controlling S T R
in Section S T R
3. Miscellaneous S T R
Property in Sec. S T R

E-10-11

Other

#2 pm

Recorded December 7 1994
at 4:15 o'clock P. M. in
Liber 3 Page 232
J. W. Applekamp
Register of Deeds

Register of Deeds Stamp & File Number

4. Lot No. , Recorded Plat
5. Private Claims
Meander corner common to Sections 29 and 28, T48N, R42W

I, John R. Garske, in a field survey on November 3, 19 94,
do hereby certify that under requirements of P.A. 74, Michigan P.A. of 1970, the corner points mentioned
in lines 1 and 2 above were in conformance with regulations and rules therefore as required in the
current manual of survey instructions of the United States Department of the Interior, Bureau of Land
Management or by a decree of a Court of Law and/or that the corner points mentioned in lines 3, 4 and 5
above were in conformance with the rules of the Michigan Board of Land Surveyors or by a Decree of a
Court of Law; established, re-established, monumented, re-monumented, recovered, found as
expressed below:

NOTE: Not more than 4 corners, all in the same town and range, may be recorded
on this certificate.

A. Description of original monument and accessories and/or subsequent restoration:

Survey by Austin Burt, August 1848. Set a cedar post from which a 6" W. ash bears S22°E, 8
links and a 8" hemlock - N09°W, 37 links.

Survey by John R. Garske, RLS 28410, 1986. Found a 1 1/2" iron pipe and witnessed as
follows: 4" balsam fir - N16°E, 11.16 feet; 4" ash - N85°E, 8.43 feet.

B. Description of corner evidence found and/or method applied in restoring or reestablishing corner:

No original evidence could be found due to logging activity. I found a 1 1/2" iron pipe as noted
above. The corner has been used by others including Keweenaw Land and Champion, Inc. and is
generally accepted as the meander corner by use and acceptance and is the only possible corner
position due to all the development referenced to it.

Corner record research on file.

ONTONAGON COUNTY
PEER APPROVED

Earl W Applekamp
Ont Co Rep
11-30-94

C. Description of monument for corner and accessories established to perpetuate locating the position of the corner:

I updated the corner position to state and county specifications by replacing the 1 1/2" iron pipe
with a 4" x 3/4" aluminum marsh rod with a 3 1/4" aluminum cap stamped: County
Remonumentation; M.C.; S-29, S-28; T48N, R42W; 1994; RLS 28410. I established the
following bearing trees and reference object: 4" balsam fir - N16°E, 11.11 feet; 4" ash - N85°E,
8.51 feet; 3" balsam fir - S58°E, 6.29 feet; 6 foot steel rail with sign - S35°W, 1.43 feet.


Signed by

John R. Garske

Date

11/28/94

Surveyor's Michigan License No. 28410

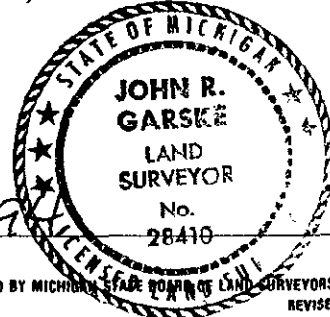

FORM APPROVED BY MICHIGAN BOARD OF LAND SURVEYORS, JAN. 28, 1971
REVISED MAY 14, 1975
REVISED JAN., 1983

FED. No. T-4-9

232