

LAND CORNER RECORDATION CERTIFICATE  
Filing Requirement of Act 74, Mich. P.A. 1970

For corners in

Ontonagon Located In: Corner Code ##  
(County)  
1. Public Land Survey T 49N R 42W C-7  
T R  
T R  
T R  
2. Property Controlling S T R  
in Section S T R  
3. Miscellaneous S T R  
Property in Sec. S T R

SURVEY &  
REMONUMENTATION

APR 07 1998

SECTION  
Register of Deeds Stamp & File Number

4. Lot No. , Recorded Plat  
5. Private Claims

Section Corner 17, 18, 19 & 20; T.49 N., R.42 W.

I, Richard L. Drahn in a field survey on December 3, 19 97, do hereby certify that under requirements of P.A. 74, Michigan P.A. of 1970, the corner points mentioned in lines 1 and 2 above were in conformance with regulations and rules therefore as required in the current manual of survey instructions of the United States Department of the Interior, Bureau of Land Management or by a decree of a Court of Law and/or that the corner points mentioned in lines 3, 4 and 5 above were in conformance with the rules of the Michigan Board of Land Surveyors or by a Decree of a Court of Law; established, re-established, monumented, re-monumented, recovered, found as expressed below:

NOTE: Not more than 4 corners, all in the same town and range, may be recorded on this certificate.

	A	B	C	D	E	F	G	H	I	J	K	L	M
2	6	5	4	3	2	1							
3													
4	7	8	9	10	11	12							
5													
6	18	17	16	15	14	13							
7													
8	19	20	21	22	23	24							
9													
10	30	29	28	27	26	25							
11													
12	31	32	33	34	35	36							
13													

A. Description of original monument and accessories and/or subsequent restoration:

Corner established by William Burt on 6/16/1848. Original B.T.s --- Spruce 14" S.50 W. 5 links (3.30') --- Spruce 8" N.45 E. 44 links (29.04') ---

Corner restored by Donald D. Lappala (12585) on 6/17/70 from the remains of the two original B.T.s, a line tree and natural feature ties. He set a stamped brass cap in a field constructed concrete and stone monument and the following B.T.s:

8" White Pine N.72 W. 25.9'  
8" Cedar N.15 W. 27.0'  
16" White Pine S.37 E. 11.3'

B. Description of corner evidence found and/or method applied in restoring or reestablishing corner:

Corner recorded in USFS Liber, Page N-5 on 9/14/72.

Research form on file with Ontonagon County records.

Recovered Mr. Lappalas' monument as described and his B.T.s as follows:

12" White Pine N.79 W. 25.89'  
9" Cedar N.12 W. 27.43' (slope distance)  
20" White Pine S.36 E. 10.79' (F.S. signs attached)


No evidence of the original B.T.s was recovered.

C. Description of monument for corner and accessories established to perpetuate locating the position of the corner:

New bearing object referenced:

8" Black Spruce N.60 E. 45.81'

PEER GROUP APPROVED  
Earl W. Applekamp  
COUNTY REGISTRAR 12-19-97

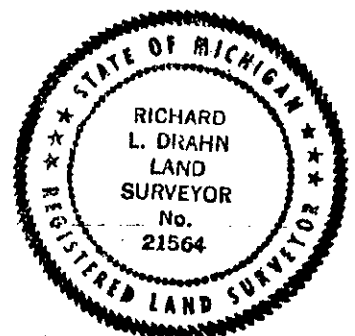

Signed by Richard L. Drahn Date December 4, 1997

Surveyor's Michigan License No. 21564