

APR 29 1995

COMMISSION

JUDITH D. ROEHM

Ontonagon County

LC 3/273 JEM

Fee:

05/09/95

14:09

.00

Page 1 of 1

# LAND CORNER RECORDATION CERTIFICATE Filing Requirement of Act 74, Mich. P.A. 1970

For corners in

ONTONAGON

(County)

Located In:

Corner Code ~~##~~

- |                                    |                         |       |
|------------------------------------|-------------------------|-------|
| 1. Public Land Survey              | T 49N. R 43W.           | E-11  |
|                                    | T _____ R _____         | _____ |
|                                    | T _____ R _____         | _____ |
|                                    | T _____ R _____         | _____ |
| 2. Property Controlling in Section | S _____ T _____ R _____ | _____ |
|                                    | S _____ T _____ R _____ | _____ |
| 3. Miscellaneous Property in Sec.  | S _____ T _____ R _____ | _____ |
|                                    | S _____ T _____ R _____ | _____ |

Register of Deeds Stamp &amp; File Number

4. Lot No. \_\_\_\_\_, Recorded Plat \_\_\_\_\_
5. Private Claims \_\_\_\_\_

Section corner, Sections 28, 29, 32 &amp; 33; T.49N., R.43W.

I, Richard L. Drahn, in a field survey on October 24, 19 94, do hereby certify that under requirements of P.A. 74, Michigan P.A. of 1970, the corner points mentioned in lines 1 and 2 above were in conformance with regulations and rules therefore as required in the current manual of survey instructions of the United States Department of the Interior, Bureau of Land Management or by a decree of a Court of Law and/or that the corner points mentioned in lines 3, 4 and 5 above were in conformance with the rules of the Michigan Board of Land Surveyors or by a Decree of a Court of Law; established; re-established; monumented; re-monumented; recovered; found as expressed below:

**NOTE: Not more than 4 corners, all in the same town and range, may be recorded on this certificate.**

	A	B	C	D	E	F	G	H	I	J	K	L	M
2	6		5		4		3		2		1		
3													
4	7		8		9		10		11		12		
5													
6	18		17		16		15		14		13		
7													
8	19		20		21		22		23		24		
9													
10	30		29		28		27		26		25		
11													
12	31		32		33		34		35		36		
13													

## A. Description of original monument and accessories and/or subsequent restoration:

Corner established by William Burt, US Deputy Surveyor, on July 3, 1848. Original bearing trees:

Elm	18"	N.15E.	18 links	(11.88 feet)
Hemlock	14"	S.15W.	43 links	(28.38 feet)

## B. Description of corner evidence found and/or method applied in restoring or reestablishing corner:

Restored corner position from the remains of the two original bearing trees. The first is a large shallow depression. The second is now a wind-thrown stump hole with downwind "line" of hemlock knots buried in the mud. Position lays within 1.9 feet of a single proportion N-S measure between  $\frac{1}{4}$  corner south and hemlock line tree stump north. Distance to recovered quarter corner east is within 3.6 feet of the east  $\frac{1}{2}$  mile distance.

ONTONAGON COUNTY

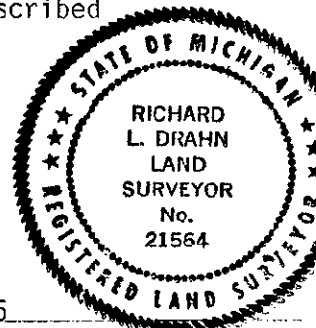
PEER APPROVED

*Out to Rep*  
*Earl W Applekamp*  
1-25-95

## C. Description of monument for corner and accessories established to perpetuate locating the position of the corner:

At the corner position I set a  $2\frac{1}{2}$ " diameter by 30" long aluminum monument with a  $3\frac{1}{4}$ " aluminum cap with magnet stamped to read: T.49N., R.43W.; S-28, S-29, S-32, S-33; 1994; R.L.S. 21564 from which I established the following new blazed and scribed bearing trees and/or objects:

11"	Basswood	S.87W.	22.99 feet
7"	Red Maple	N.63E.	25.57 feet
9"	Sugar Maple	S.05E.	24.29 feet
6'	Steel rail	S.50E.	2.4 feet

Signed by Richard L. DrahnDate January 25, 1995Surveyor's Michigan License No. 21564

USFS # V-9

FORM APPROVED BY MICHIGAN STATE BOARD OF LAND SURVEYORS, JAN. 28, 1971  
REVISED MAY 14, 1975  
REVISED JAN. 1983