

DEC 1 8 1996

COMMISSION

LAND CORNER RECORDATION CERTIFICATE  
Filing Requirement of Act 74, Mich. P.A. 1970

JUDITH D. ROEHM

Ontonagon County

LC 4/ 27 JEM

03/04/96

15:25

Fee: 9.00

Page 1 of 1

For corners in

Ontonagon

(County)

Located in:

Corner Code ##

1. Public Land Survey

T 49N. R 38 W.

E-1

T 50N. R 38 W.

E-13

2. Property Controlling  
in Section

S T R

S T R

3. Miscellaneous  
Property in Sec.

S T R

S T R

Register of Deeds Stamp &amp; File Number

4. Lot No. , Recorded Plat

5. Private Claims

Section Corner 4, 5, 32, &amp; 33; T.49-50 N., R.38 W.

Richard L. Drahn, in a field survey on July 18, 1995, do hereby certify that under requirements of P.A. 74, Michigan P.A. of 1970, the corner points mentioned in lines 1 and 2 above were in conformance with regulations and rules therefore as required in the current manual of survey instructions of the United States Department of the Interior, Bureau of Land Management or by a decree of a Court of Law and/or that the corner points mentioned in lines 3, 4 and 5 above were in conformance with the rules of the Michigan Board of Land Surveyors or by a Decree of a Court of Law; established, re-established, monumented, re-monumented, recovered, found as expressed below:

NOTE: Not more than 4 corners, all in the same town and range, may be recorded on this certificate.

A. Description of original monument and accessories and/or subsequent restoration:

Original corner established by Austin Burt, Deputy Surveyor on June 24, 1847.  
Original bearing trees:

Y. Birch 12" N.57 E. 25 links (16.50 feet)

Fir 12" N.13 W. 21 links (13.86 feet)

Bearing trees by Artimas Curtip, Deputy Surveyor on June 12, 1851.

Hemlock 7" S.33 W. 18 links (11.88 feet)

Y. birch 8" S.77 E. 31 links (20.46 feet)

Corner research on file with Ontonagon County records. (6/6/95)

B. Description of corner evidence found and/or method applied in restoring or reestablishing corner:

No evidence of original corner or bearing trees found. Corner position re-established on line between and proportionate distance from the section corner 1 mile east and the quarter corner ½ mile west.

An F.S. Location Poster on a downed 10" Elm tree bears S.05 W., 6 feet from the re-established corner position.

PEER GROUP APPROVED

Paul W. Applekamp  
COUNTY REPRESENTATIVE

C. Description of monument for corner and accessories established to perpetuate locating the position of the corner:


At the corner position I set a 2½" X 30" long aluminum monument with a 3¼" aluminum cap, stamped to read: T.49-50 N., R.38 W.; S-4, S-5, S-32, S-33; 1995; R.L.S. 21564. From which I established the following new blazed and scribed bearing trees:

6" Sugar Maple N.14 E. 13.33 feet

8" Hemlock S.65 E. 18.05 feet

6" Sugar Maple S.40 W. 27.83 feet

6' Steel rail S.02 W. 1.75 feet

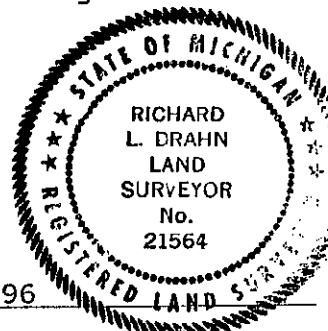

Signed by Richard L. Drahn

Date February 26, 1996

Surveyor's Michigan License No. 21564