

LAND CORNER RECORDATION CERTIFICATE
Filing Requirement of Act 74, Mich. P.A. 1970

For corners in

Ontonagon Located In: Corner Code #
(County)
1. Public Land Survey T 50N R 38W F-3
T R
T R
T R
2. Property Controlling S T R
in Section S T R
3. Miscellaneous S T R
Property in Sec. S T R

SURVEY &
REMONUMENTATION

APR 07 1998

SECTION

Register of Deeds Stamp & File Number

4. Lot No. , Recorded Plat
5. Private Claims

I, Joseph C. Domitrovich, in a field survey on November 7, 19 97 do hereby state that under requirements of P.A. 74, Michigan P.A. of 1970, the corner points mentioned in lines 1 and 2 above were in conformance with regulations and rules therefore as required in the current manual of survey instructions of the United States Department of the Interior, Bureau of Land Management or by a decree of a Court of Law and/or that the corner points mentioned in lines 3, 4 and 5 above were in conformance with the rules of the Michigan Board of Land Surveyors or by a Decree of a Court of Law; established, re-established, monumented, recovered, found as expressed below:

NOTE: Not more than 2 corners, all in the same town and range, may be recorded on this certificate.

(F-3) 1/4 Corner Common to Section 4 & 9, T 50N, R 38W

A. Description of original monument and accessories and/or subsequent restoration:

1847 - Sylvester W. Higgins set post
10" Balsam S 10° W 2 links
4" Y. Birch N 15° E 6 links

B. Description of corner evidence found and/or method applied in restoring or reestablishing corner:

Original corner and accessories were not recovered.

I re-established the corner by single proportionate measurement. This position works well with stream crossings indicated in original notes. The corner falls on a hillside South of creek bed.

Research on file with County Remonumentation Representative.

C. Description of monument for corner and accessories established to perpetuate locating the position of the corner:

Corner is a 3/4" x 48" aluminum rod driven into the hillside, with a 3" diameter aluminum cap stamped to read: COUNTY REMONUMENTATION; T.50N, R.38W; 1/4; S. 4, S. 9; 1997; P.S. 37273.


Witnesses:

5" Cedar	N 44° E	17.15'
4" Poplar	S 22° E	13.64'
10" Balsam	S 73° W	20.62'
Steel Sign Post	North	1.03' (to face)
NE Cor. Section 9	S 89° 10' 00" E	2712.71'
NW Cor. Section 9	N 89° 10' 00" W	2712.71'

PEER GROUP APPROVED

COUNTY REPRESENTATIVE

11-11-97

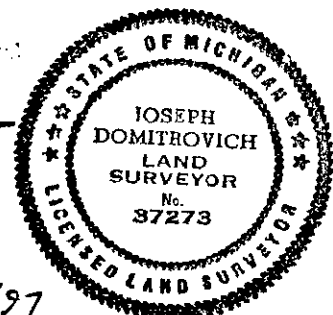

NOTE: Bearings are magnetic. Distances are to nail in side of witness objects unless noted.

Signed by Joseph C. Domitrovich

Date 11/10/97

Surveyor's Michigan License No. 37273