

LAND CORNER RECORDATION CERTIFICATE
Filing Requirement of Act 74, Mich. P.A. 1970

OCT 3 0 1997

For corners in

Ontonagon
(County)

Located In:

Corner Code #

1. Public Land Survey

T 50 R 38 K-5
T R
T R
2. Property Controlling
in Section

S T R
S T R
S T R
S T R

3. Miscellaneous
Property in Sec.

S T R
S T R
S T R

COMMISSION

JUDITH D. ROEHM 07/18/97
Ontonagon County 11:31
LC 4/314 JJT Feet: 9.00
Page 1 of 1

Register of Deeds Stamp & File Number

4. Lot No. , Recorded Plat
5. Private Claims

I, Joseph C. Domitrovich, in a field survey on July 14, 1997, do hereby state that under requirements of P.A. 74, Michigan P.A. of 1970, the corner points mentioned in lines 1 and 2 above were in conformance with regulations and rules therefore as required in the current manual of survey instructions of the United States Department of the Interior, Bureau of Land Management or by a decree of a Court of Law and/or that the corner points mentioned in lines 3, 4 and 5 above were in conformance with the rules of the Michigan Board of Land Surveyors or by a Decree of a Court of Law; established, re-established, monumented, recovered, found as expressed below:

NOTE: Not more than 2 corners, all in the same town and range, may be recorded on this certificate.

	A	B	C	D	E	F	G	H	I	J	K	L	M
1													
2	6		5		4		3		2		1		
3													
4	7		8		9		10		11		12		
5													
6	18		17		16		15		14		13		
7													
8	19		20		21		22		23		24		
9													
10	30		29		28		27		26		25		
11													
12	31		32		33		34		35		36		
13													

(K-5) Corner of Sections 11, 12, 13, & 14, T50N, R38W

A. Description of original monument and accessories and/or subsequent restoration:

1847 - Sylvester W. Higgins, D.S., set post
10" Yellow Birch S 73° W 21 links
10" Balsam N 30° E 14 links

1970 - R.S. Scott Engineering, in road reconstruction plans on file at Ontonagon County Road Commission office, set a P.K. nail at approximate Section Corner in centerline of Simar-Wasas Road on the extension of centerline Evergreen Road East and West.
30" Poplar N 60° E 72.91'
6" Cedar N 70° W 82.46'

B. Description of corner evidence found and/or method applied in restoring or reestablishing corner:

The original corner and accessories have been destroyed by road construction and extensive farming.

R.S. Scott Corner and accessories have also been destroyed by road reconstruction. I found a 6" Cedar in the area of the R.S. Scott B.T. The base of this tree is buried under 6' of fill and I was unable to determine whether it was the Scott B.T. I therefore re-established R.S. Scott position at the intersection of centerlines.

This position works well with corners to North, South, East, and West. Distance to 1/4 corner to North works reasonably well with R.S. Scott distance.

I accepted this position as the Section corner and have monumented it as such.

Research on file with County Remonumentation Representative.

C. Description of monument for corner and accessories established to perpetuate locating the position of the corner:


Corner is a 5/8" iron pin with a 3" diameter aluminum cap stamped to read: COUNTY REMONUMENTATION; T.50N, R.38W; S. 11, S. 12, S. 13, S. 14; 1997; P.S. 37273. I also established a reference monument (R.M.) to the Southwest, a 2" x 30" aluminum pipe with a 3" diameter aluminum cap stamped to indicate that the Section corner is N 43° E 35.31'.

Witnesses:

5" Cedar N 70° W 83.34'
Power Pole N 41° E 56.21'
Power Pole S 45° E 40.75'
R.M. S 42° 54' 02" W 35.31'
1/4 Cor. Sec. 11 N 00° 43' 32" E 2666.85' (meas.) 2665.90' (R.S. Scott)

PEER GROUP APPROVED

JOSEPH DOMITROVICH
COUNTY REPRESENTATIVE
7-15-97

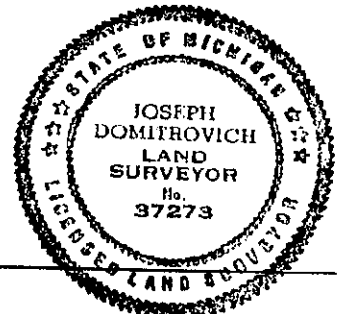

NOTE: Bearings are magnetic. Distances are to nail in side of witness objects unless noted.

Signed by Joseph C. Domitrovich

Date 7/14/97

Surveyor's Michigan License No. 37273