

DEC 16 1996

COMMISSION

JUDITH D. ROEHM
Ontonagon County
LC 4/130 JEM. Fee: 9.00
07/12/96 15:05
Page 1 of 1

LAND CORNER RECORDATION CERTIFICATE
Filing Requirement of Act 74, Mich. P.A. 1970

For corners in Ontonagon Located In: Corner Code #
(County)

- | | | |
|---|---------------------------|------------|
| 1. Public Land Survey | T <u>50N</u> R <u>39W</u> | <u>E-2</u> |
| | T _____ R _____ | _____ |
| | T _____ R _____ | _____ |
| | T _____ R _____ | _____ |
| 2. Property Controlling
in Section | S _____ T _____ R _____ | _____ |
| | S _____ T _____ R _____ | _____ |
| 3. Miscellaneous
Property in Section | S _____ T _____ R _____ | _____ |
| | S _____ T _____ R _____ | _____ |

Register of Deeds Stamp & File Number

4. Lot No. _____, Recorded Plat _____
5. Private Claims _____

I, Joseph C. Domitrovich, in a field survey on June 6, 19 96, do hereby certify that under requirements of P.A. 74, Michigan P.A. of 1970, the corner points mentioned in lines 1 and 2 above were in conformance with regulations and rules therefore as required in the current manual of survey instructions of the United States Department of the Interior, Bureau of Land Management or by a decree of a Court of Law and/or that the corner points mentioned in lines 3, 4 and 5 above were in conformance with the rules of the Michigan Board of Professional Surveyors or by a Decree of a Court of Law; established, re-established, monumented, re-monumented, recovered, found as expressed below:

NOTE: Not more than 4 corners, all in the same town and range, may be recorded on this certificate.

A. Description of original monument and accessories and/or subsequent restoration:

(E-2) 1/4 Corner Sections 4 & 5, T50N, R39W

1847 - S.W. Higgins set post
8" Hemlock S 20° W 10 links
12" Sugar N 65° E 39 links

B. Description of corner evidence found and/or method applied in restoring or reestablishing corner:

Found no remains of original corner or accessories due to heavy logging activity since the 1930's. At the corner position I found an old blazed-painted line running to the North and an old fallen wire fence running to the East and West. Measurements to the stream to the north and to section corners to the north and south are in accordance with the original GLO distances. I accepted the intersection of the blazed line and fenceline as the 1/4 corner position and monumented it as such.

Research on file with County Remonumentation Representative.

C. Description of monument for corner and accessories established to perpetuate locating the position of the corner:


Corner is a 5/8" x 24" rebar with a 3" diameter aluminum cap stamped to read: T.50N., R.39W.; 1/4 S.4, S.5; 1996; P.S. 37273. Corner is driven into the roots of a Hard Maple.

Witnesses:

12" Basswood	N 24° E	12.74'
Steel Sign Post	East	0.61'
12" Hard Maple	S 35° E	16.34'
7" Hard Maple	South	1.52'
6" Hard Maple	N 65° W	7.97'

PEER GROUP APPROVED

Paul W. Applekamp
COUNTY REPRESENTATIVE
07-08-96

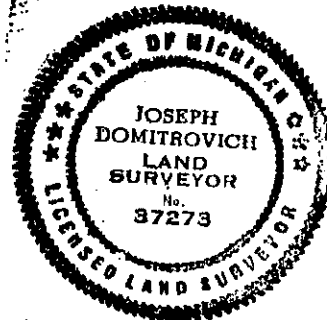

NOTE: Bearings are magnetic. Distances are to nail in side of witness objects unless noted.

Signed by J. C. Domitrovich

Date 7/3/96

Surveyor's Michigan License No. 37273