

JUDITH D. ROEHM 1P
LAND CORNER RECORDATION CERTIFICATE Ontonagon County
Filing Requirement of Act 74, Mich. P.A. 1970 of 1 LC 5/ 87
Ontonagon County Remonumentation Corner Rec. Date 06/25/98 Time 12:07
RECORDING FEE: 9.00

For corners in

Ontonagon County Located in: Corner Code #

1. Public Land Survey

T51N R37W A-13
T51N R38W M-13

2. Property Controlling
In Section

S T R
S T R

3. Miscellaneous
Property in Sec.

S T R
S T R

4. Lot No. , Recorded Plat

5. Private Claims

SURVEY
REMONUMENTATION

JAN 11 1999

SECTION

Register of Deeds Stamp & File Number

	A	B	C	D	E	F	G	H	I	J	K	L	M
1													
2	6		5		4		3		2		1		
3													
4	7		8		9		10		11		12		
5													
6	16		17		18		19		20		21		
7													
8	19		20		21		22		23		24		
9													
10	30		29		28		27		26		25		
11													
12	31		32		33		34		35		36		
13													

I, Joseph C. Domitrovich, in a field survey on June 16, 1998, do hereby state that under requirements of P.A. 74, Michigan P.A. of 1970, the corner points mentioned in lines 1 and 2 above were in conformance with regulations and rules therefore as required in the current manual of survey instructions of the United States Department of the Interior, Bureau of Land Management or by a decree of a Court of Law and/or that the corner points mentioned in lines 3, 4 and 5 above were in conformance with the rules of the Michigan Board of Land Surveyors or by a Decree of a Court of Law; established, re-established, monumented, recovered, found as expressed below:

NOTE: Not more than 2 corners, all in the same town and range, may be recorded on this certificate.

A. Description of original monument and accessories and/or subsequent restoration:
(A-13) Township Corner Common to Section 31, T51N, R37W & Section

36, T51N, R38W

Corner is on the 5th Correction Line

1845 - Austin Burt set post

16" Hemlock N 44° E 7 links
8" Fir N 20° W 24 links

No subsequent record found.

B. Description of corner evidence found and/or method applied in restoring or reestablishing corner:

I found no remains of the original corner or accessories. I re-established the corner at a proportionate distance between the Southwest Corner of Section 36, T51N, R38W and the South ¼ Corner of Section 31, T51N, R37W. I held the middle of an old mining road bed for the North-South position. The corner now falls in a beaver marsh in middle of submerged road bed.

Research on file with County Remonumentation Representative.

PEER GROUP APPROVED


Carl W. Spelkamp
COUNTY REPRESENTATIVE

C. Description of monument for corner and accessories established to perpetuate locating the position of the corner: 6-17-98

Corner is a ½" x 8' aluminum rod with a 3" diameter aluminum cap stamped to read: COUNTY REMONUMENTATION; S.31, S.36; T.51N, R.37W, R.38W; S.C.; 1998; P.S. 37273. I also established two reference monuments in the middle of the old railroad grade West of the corner. Each consists of a ½" x 24" iron pin with a 2" diameter aluminum cap stamped "REFERENCE MONUMENT".

Witnesses:

Reference Monument #1	N 48° 25' 57" W	141.78'	
Reference Monument #2	S 43° 56' 43" W	158.88'	
Steel Sign Post	North	3.73'	
Steel Sign Post	East	2.10'	
S ¼ Cor. Section 31, T51N, R37W	N 89° 58' 59" E	2778.36'	(2772' GLO)
S ¼ Cor. Section 36, T51N, R38W	S 89° 52' 22" W	2646.06'	(2640' GLO)

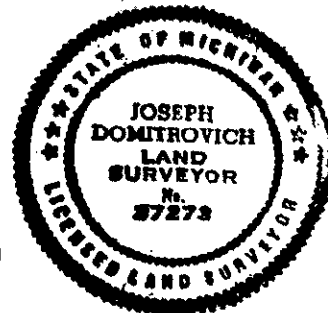

NOTE: Bearings to witness objects are magnetic. Distances are to a nail in side of the witness object unless noted.

Signed by *J. C. Domitrovich*

Date 6-17-98

Surveyor's Michigan License No. 37273

FORM APPROVED BY MICHIGAN STATE BOARD OF PROFESSIONAL SURVEYORS, JAN. 28, 1971
REVISED MAY 14, 1975
REVISED JAN., 1983
REVISED OCT., 1995