

## LAND CORNER RECORDATION CERTIFICATE

Filing Requirement of Act 74, Mich. P.A. 1970

Ontonagon County Remonumentation Corner

Ontonagon County

East 1 of 1

LC

5/289

Rec. Date 07/27/99 Time 14:57

RECORDING FEE:

9.00

For corners in

Ontonagon County	Located in:	Corner Code #
1. Public Land Survey	T51N R39W	D-5
	T R	
	T R	
	T R	
2. Property Controlling in Section	S T R	
	S T R	
3. Miscellaneous Property in Sec.	S T R	
	S T R	
4. Lot No. , Recorded Plat		
5. Private Claims		

## SURVEY &amp; REMONUMENTATION

MAR 23 2000

## SECTION

Register of Deeds Stamp &amp; File Number

	A	B	C	D	E	F	G	H	I	J	K	L	M
1													
2	6		5		4		3		2		1		
3													
4	7		8		9		10		11		12		
5													
6	18		17		16		15		14		13		
7													
8	19		20		21		22		23		24		
9													
10	30		29		28		27		26		25		
11													
12	31		32		33		34		35		36		
13													

I, Joseph C. Domitrovich, in a field survey on July 15, 1999, do hereby state that under requirements of P.A. 74, Michigan P.A. of 1970, the corner points mentioned in lines 1 and 2 above were in conformance with regulations and rules therefore as required in the current manual of survey instructions of the United States Department of the Interior, Bureau of Land Management or by a decree of a Court of Law and for that the corner points mentioned in lines 3, 4 and 5 above were in conformance with the rules of the Michigan Board of Land Surveyors or by a Decree of a Court of Law; established, re-established, monumented, recovered, found as expressed below:

NOTE: Not more than 2 corners, all in the same town and range, may be recorded on this certificate.

## A. Description of original monument and accessories and/or subsequent restoration:

(D-5) ¼ Corner Common to Sections 8 and 17, T51N, R39W.

1845 – Austin Burt set a Hemlock Post.

7" Sugar	S37°W	12 links
7" Sugar	N12°E	35 links

1949 – Michigan State Highway Department calls for this corner on their U.S. Highway 45 Construction Plans. They found a 1" iron pin 820.55' East of centerline. Ties:

4" Maple	N13°E	25.44'
4" Elm	N76°W	14.42'
6" Maple	N55°E	9.71'

PEER GROUP APPROVAL

*Carl W. Applekamp* 7-20-99  
COUNTY REPRESENTATIVE

## B. Description of corner evidence found and/or method applied in restoring or reestablishing corner:


I found no remains of the original corner or accessories. I found the iron pin called for by MSHD. It falls on the extension of a fence to the South. It falls 820.5' East of centerline of U.S. 45. I found two remaining MSHD Bearing Trees, the Elm to the NW (now dead and fallen) and the Maple N13°E. Distances from these to the 1" iron pin work well. Distances to corners east and west work reasonably well. I accepted the 1" iron pin as the ¼ corner and replaced it with a county monument.

Research on file with County Remonumentation Representative.

## C. Description of monument for corner and accessories established to perpetuate locating the position of the corner:

Corner is a 2 ½" x 30" aluminum pipe with a 3" diameter aluminum cap stamped to read: COUNTY REMONUMENTATION; ¼; S.8, S.17, T51N, R39W; 1999; P.S. 37273. Ties:

10" Soft Maple	N16°E	25.31' (M.S.H.D. B.T. – added new nail)
14" Soft Maple	N65°E	6.72'
7" Soft Maple	S06°E	6.25'
4" Poplar	N83°W	12.50'
Steel Sign Post	North	3.09'
SW Corner Sec. 8	N89°47'10"W	2628.09'
SE Corner Sec. 8	N89°57'35"E	2649.01'

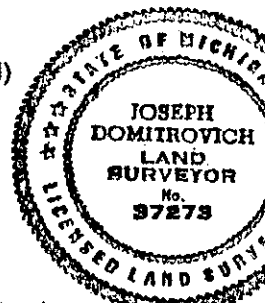

NOTE: Bearings to witness objects are magnetic. Distances are to a nail in side of the witness object unless noted.

Signed by

*Joseph C. Domitrovich*

Date

7/20/99

Surveyor's Michigan License No. 37273