

DEC 16 1996

COMMISSION

JUDITH D. ROEHM
Ontonagon County
LC 4/ 43 JEM Fee: 9.00
Page 1 of 1

LAND CORNER RECORDATION CERTIFICATE
Filing Requirement of Act 74, Mich. P.A. 1970

For corners in Ontonagon Located In: Corner Code #
(County)

| | | | | | |
|-------------------------|---|-----|---|-----|-----|
| 1. Public Land Survey | T | 51N | R | 39W | G-9 |
| | T | | R | | |
| | T | | R | | |
| | T | | R | | |
| 2. Property Controlling | S | | T | R | |
| in Section | S | | T | R | |
| 3. Miscellaneous | S | | T | R | |
| Property in Section | S | | T | R | |

Register of Deeds Stamp & File Number

4. Lot No. _____, Recorded Plat _____
5. Private Claims _____

I, Joseph C. Domitrovich, in a field survey on November 6, 1995, do hereby certify that under requirements of P.A. 74, Michigan P.A. of 1970, the corner points mentioned in lines 1 and 2 above were in conformance with regulations and rules therefore as required in the current manual of survey instructions of the United States Department of the Interior, Bureau of Land Management or by a decree of a Court of Law and/or that the corner points mentioned in lines 3, 4 and 5 above were in conformance with the rules of the Michigan Board of Professional Surveyors or by a Decree of a Court of Law; established, re-established, monumented, re-monumented, recovered, found as expressed below:

NOTE: Not more than 4 corners, all in the same town and range, may be recorded on this certificate.

A. Description of original monument and accessories and/or subsequent restoration:

(G-9) Corner of Sections 21, 22, 27, and 28, T51N, R39W

1845 - Austin Burt for William A. Burt, set Maple post

10" Hemlock S 18° W 35 links

7" Sugar N 54° E 26 links

1947 - U.S. Highway 45 R.O.W. Drawings on file at Ontonagon Co. Rd. Commission show a distance from centerline-east to this corner and west to the section corner to the west.

1965 - M.S.H.D. plans for U.S. Highway 45 on file at Ontonagon Co. Rd. Commission show same distances as 1947, and an angle off of tangent centerline to this corner. They call for corner as being a 1 1/2" iron pipe and give three witnesses.

B. Description of corner evidence found and/or method applied in restoring or reestablishing corner:

All original evidence has been obliterated due to logging and farming around corner.

Found a 1 1/2" pipe (5' long) at corner position. It worked very well with M.S.H.D. angle off of tangent centerline. Could find no remains of M.S.H.D. witnesses. Distances to corners West and North work well.

Accepted this position as the section corner and monumented it as such.

Research on file with County Remonumentation Representative.

C. Description of monument for corner and accessories established to perpetuate locating the position of the corner:

Corner is a 2" x 30" aluminum pipe with a 3" diameter aluminum cap stamped to read: T.51N, R.39W.; Sections, 21, 22, 27, 28; 1996; P.S. 37273. Corner falls 47' south of old railroad grade and on a north-south fenceline. Also falls on s. edge of treeline to the east.


Witnesses:

| | | |
|-----------------|---------|--------|
| 6" Black Ash | S 40° W | 16.77' |
| 6" Poplar | N 60° W | 11.65' |
| 3" Soft Maple | N 02° W | 15.68' |
| 4" Soft Maple | N 47° E | 7.42' |
| Steel Sign Post | South | 1.03' |

PEER GROUP APPROVED

COUNTY REPRESENTATIVE

05-07-96

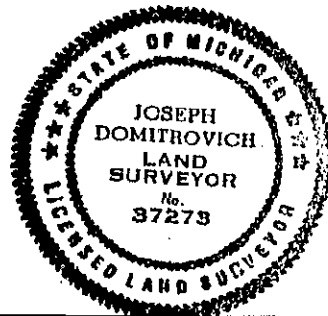

NOTE: Bearings are magnetic. Distances are to nail in side of witness objects unless noted.

Signed by Joseph C. Domitrovich

Date 5/6/96

Surveyor's Michigan License No. 37273