

LAND CORNER RECORDATION CERTIFICATE
Filing Requirement of Act 74, Mich. P.A. 1970

For corners in
Ontonagon
(County)

Located In:

Corner Code #

1. Public Land Survey T 51N R 40W I-1
T R
T R
T R
2. Property Controlling S T R
In Section S T R
3. Miscellaneous S T R
Property in Section S T R
4. Lot No. , Recorded Plat
5. Private Claims

SURVEY &
REMONUMENTATION

MAY 22 1997

COMMISSION

Register of Deeds Stamp & File Number

I, Joseph C. Domitrovich, in a field survey on August 5, 19 96,
do hereby certify that under requirements of P.A. 74, Michigan P.A. of 1970, the corner points mentioned
in lines 1 and 2 above were in conformance with regulations and rules therefore as required in the current
manual of survey instructions of the United States Department of the Interior, Bureau of Land
Management or by a decree of a Court of Law and/or that the corner points mentioned in lines 3, 4 and
5 above were in conformance with the rules of the Michigan Board of Professional Surveyors or by a
Decree of a Court of Law; established, re-established, monumented, re-monumented, recovered, found
as expressed below:

NOTE: Not more than 4 corners, all in the same town and range, may be recorded
on this certificate.

A. Description of original monument and accessories and/or subsequent restoration:

(I-1) Closing Corner Sections 3 and 2, T51N, R40W

1845 - William A. Burt, intersected North Boundary 52 links (34.32') East of corner and set post

10" Hemlock S 53° E 22 links

16" Hemlock S 24° W 9 links

1979 - Robert Mick P.S. 16936, in Survey for Ontonagon County Airport (on file with Plats at Ontonagon County Register of
Deeds) re-established closing corner at record GLO distance (34.32') east of the standard corner Sections 34 & 35,
T52N, R40W, and set a concrete monument. He established 3 witnesses to this corner. (Note - witnesses to this corner
and the standard corner are reversed on the drawing.)

B. Description of corner evidence found and/or method applied in restoring or reestablishing corner:

All remains of the original corner and accessories have been destroyed by road construction and farming.

I found the remains of a concrete monument 3" below the asphalt, 3' East of centerline of North-South Noble Road. I also found
2 remaining witnesses which were consistent with the Mick Survey. The found monument also worked well with the distances
to corners to the west and south.

I accepted the concrete monument as the closing corner and monumented it as such.

Research on file with County Remonumentation Representative.

C. Description of monument for corner and accessories established to perpetuate locating the position of the corner:

Corner is a 5/8" x 24" rebar with a 3" diameter aluminum cap stamped to read: T.51N., R.40W.; S.3, S.2; C.C.; 1996;
P.S. 37273. Corner falls 4' East of centerline of North-South Noble road and in line with fences to the east and west. I also
established a Reference monument (R.M.) which consists of a 2" x 30" aluminum pipe with 3" diameter aluminum cap stamped to
indicate that the actual corner is west 20.42'.

Witnesses

(R.M.) East 20.42'
Steel Sign Post East 21.28'
18" Soft Maple S 12° E 98.15'
Anchor Pole S 42° W 53.05'

Standard Corner Sections 34, & 35, T52N, R40W West 34.30' (2" Aluminum pipe with 3" aluminum cap.)


NOTE: Bearings are magnetic. Distances are to nail in side of witness objects unless noted.

Signed by Joseph C. Domitrovich

Date 8/8/96

Surveyor's Michigan License No. 37273

	A	B	C	D	E	F	G	H	I	J	K	L	M
2	6		5		4		3		2		1		
3													
4	7		8		9		10		11		12		
5													
6	18		17		16		15		14		13		
7													
8	19		20		21		22		23		24		
9													
10	30		29		28		27		26		25		
11													
12	31		32		33		34		35		36		
13													

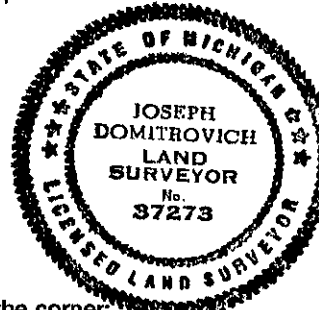

PEER GROUP APPROVED
Earl W. Applikans
COUNTY REPRESENTATIVE 08-08-96