

LAND CORNER RECORDATION CERTIFICATE

Filing Requirement of Act 74, Mich. P.A. 1970

JUDITH D. ROEHM

Ontonagon County

1P

LC 5/247

File Date 11/23/1999

Time 18:37:17

RECORDING FEE:

9.00

For corners in

Ontonagon County

Located in:

Corner Code #

1. Public Land Survey

T51N R40W

K-6

T
T
R
R
2. Property Controlling in Section

S

3. Miscellaneous

S

Property in Sec.

S

4. Lot No.

Recorded Plat

5. Private Claims

SURVEY & REMONUMENTATION

MAR 23 2000

SECTION

Register of Deeds Stamp & File Number

	A	B	C	D	E	F	G	H	I	J	K	L	M
1													
2	6	5	4	3	2	1							
3													
4	7	8	9	10	11	12							
5													
6	18	17	16	15	14	13							
7													
8	19	20	21	22	23	24							
9													
10	30	29	28	27	26	25							
11													
12	31	32	33	34	35	36							
13													

I, Joseph C. Domitrovich, in a field survey on November 4, 1999, do hereby state that under requirements of P.A. 74, Michigan P.A. of 1970, the corner points mentioned in lines 1 and 2 above were in conformance with regulations and rules therefore as required in the current manual of survey instructions of the United States Department of the Interior, Bureau of Land Management or by a decree of a Court of Law and/or that the corner points mentioned in lines 3, 4 and 5 above were in conformance with the rules of the Michigan Board of Land Surveyors or by a Decree of a Court of Law; established, re-established, monumented, recovered, found as expressed below:

NOTE: Not more than 2 corners, all in the same town and range, may be recorded on this certificate.

A. Description of original monument and accessories and/or subsequent restoration:

(K-6) 1/4 Corner Common to Sections 14 & 13, T51N, R40W.

1845 William A. Burt set a Hemlock Post with ties:

10" Fir	N 20°E	35 links
10" Sugar	N 16°W	17 links

No Subsequent Restoration Found.

B. Description of corner evidence found and/or method applied in restoring or reestablishing corner:

I found no remains of the original corner or accessories. I found no evidence whatsoever of the 1/4 corner. Therefore I treated it as a lost corner and re-established it by Single Proportionate Measurement between Section corners to the North and South.

Research on file with County Remonumentation Representative.

PEER GROUP APPROVED

Carl W. Applekamp


COUNTY 87273

11-09-99

C. Description of monument for corner and accessories established to perpetuate locating the position of the corner:

Corner is a 2 1/2" x 30" aluminum pipe with a 3" diameter aluminum cap stamped to read: County Remonumentation; T51N, R40W; 1/4; S. 13, S. 14; 1999; P.S. 37273. Corner falls 1/3 of the way down the steep slope of section descending to the East. Ties:

6" Soft Maple	S 09°W	9.32'
4" Hard Maple	S 75°W	5.40'
6" Hard Maple	N 10°E	24.41'
Steel Sign Rail	East	0.80' (to Face)
NE Corner Section 14	N 00°24'22"W	2621.64'
SE Corner Section 14	S 00°24'22"E	2621.64'

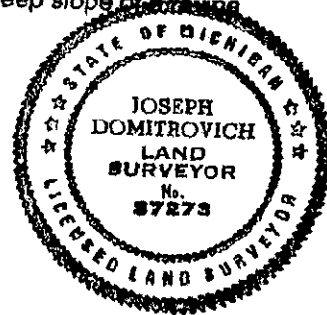

NOTE: Bearings to witness objects are magnetic. Distances are to a nail in side of the witness object unless noted.

Signed by

Joseph C. Domitrovich

Date

11/09/99

Surveyor's Michigan License No. 37273