

LAND CORNER RECORDATION CERTIFICATE
Filing Requirement of Act 74, Mich. P.A. 1970

JUDITH D. ROEHN
 Ontonagon County
 Page 1 of 2
 JEM Date 11/23/1999 Time 18:38:03
 RECORDING FEE: 11.00

For corners in

Ontonagon County Located in: Corner Code #

- | | | | | |
|-------------------------|---|-----------|---------|---------------|
| 1. Public Land Survey | | T51N R40W | L/M - 5 | 007 |
| | | T | R | |
| | | T | R | |
| | | T | R | |
| 2. Property Controlling | S | T | R | |
| in Section | S | T | R | |
| 3. Miscellaneous | S | T | R | |
| Property in Sec. | S | T | R | |
| 4. Lot No. | | | | Recorded Plat |
| 5. Private Claims | | | | |

**SURVEY &
 REMONUMENTATION**

MAR 23 2000

SECTION

Register of Deeds Stamp & File Number

	A	B	C	D	E	F	G	H	I	J	K	L	M
1													
2	6		5		4		3		2		1		
3													
4	7		8		9		10		11		12		
5													
6	18		17		16		15		14		13		
7													
8	19		20		21		22		23		24		
9													
10	30		29		28		27		26		25		
11													
12	31		32		33		34		35		36		
13													

I, Joseph C. Domitrovich, in a field survey on November 1, 1999, do hereby state that under requirements of P.A. 74, Michigan P.A. of 1970, the corner points mentioned in lines 1 and 2 above were in conformance with regulations and rules therefore as required in the current manual of survey instructions of the United States Department of the Interior, Bureau of Land Management or by a decree of a Court of Law and /or that the corner points mentioned in lines 3, 4 and 5 above were in conformance with the rules of the Michigan Board of Land Surveyors or by a Decree of a Court of Law; established, re-established, monumented, recovered, found as expressed below:

NOTE: Not more than 2 corners, all in the same town and range, may be recorded on this certificate.

A. Description of original monument and accessories and/or subsequent restoration:

(L/M - 5) Meander Corner on the left bank of Ontonagon River, between Sections 12 & 13, T51N, R40W

1845 William A. Burt set a post on the left bank of the Ontonagon River, 5.35 chains (353.10') West of the SE corner of Section 12, with ties:

16" Maple S 18°W 62 links

No Record of Subsequent Restoration

B. Description of corner evidence found and/or method applied in restoring or reestablishing corner:

I found no remains of the original corner or accessories. The course of the Ontonagon River has changed dramatically since 1845. The river no longer runs between the Meander Corner and the Section corner as called for in the original field notes. It now runs East of the Section corner. I re-established a position for the meander corner by single proportionate measurement between the Section corner and ¼ corner. (SEE BACK FOR SKETCH)


Research on file with County Remonumentation Representative.

PEER GROUP APPROVED
Earl W. Applekamp
 COUNTY REPRESENTATIVE 11-09-99

C. Description of monument for corner and accessories established to perpetuate locating the position of the corner:

Corner is a 2 ½" x 30" aluminum pipe with a 3" diameter aluminum cap stamped to read: County Remonumentation; T51N, R40W, M.C.; S. 12, S. 13; 1999; P.S. 37273. I also stamped "Sec. Cor. Is S 89-40E 350.03'" on the cap. Ties:

6" Box Elder	S 69°W	20.96'
5" Box Elder	N 00°E	28.19'
4" Hard Maple	N 70°E	28.27'
Steel Sign Rail	South	0.91'
SE Corner Section 12	S 89°39'45"E	350.03'
S ¼ Corner Section 12	N 89°39'45"W	2250.65'

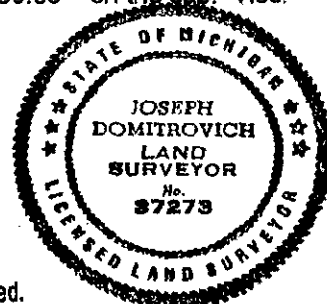

NOTE: Bearings to witness objects are magnetic. Distances are to a nail in side of the witness object unless noted.

Signed by J. C. Domitrovich

Date 11/09/99

Surveyor's Michigan License No. 37273