11 JUDITH D. FOEHI Ontoneson County 5/ 75 LC Page 1 of 1 JEN Pec. Date 06/22/98 Time 11:31

LAND CORNER RECORDATION CERTIFICATE Filing Requirement of Act 74, Mich. P.A. 1970

For corners in ONTONACON	Located In:	Corner Code #
(County) 1. Public Land Survey	T <u>51N</u> F T F T F T F	241W <u>C-13</u>
Property Controlling in Section Miscellaneous Property in Sec.	S TF S TF S TF	


Register of Deeds Stamp & File Number

i Latitio	Recorded	Plat					
n total Claims							
), Private Ciainia	to Secti	ions 3	1 &	32,	T51N	R41W.	

Section Corner common to Sections 31 & 32, T51N R41W.

[Earl W. Applekamp], in a field survey on May 22 ____, 1998 do hereby state that under requirements of P.A. 74, Michigan P.A. of 1970, the corner points mentioned in lines 1 and 2 above were in conformance with regulations and rules therefore as required in the current manual of survey instructions of the united States Department of the Interior, Bureau of Land Management or by a decree of a Court of Law and for United States Department of the Interior, Bureau of Land Management or by a decree of a Court of Law established. Regulations are the state of the Michigan Board of Land Surveyors or by a Decree of a Court of Law established. that the contract points meritioned in since of a court of Law; established, re-established, monumented, recovered, found as expressed below:

NOTE: Not more than 2 corners, at in the same town and range, may be recorded on this certificate.

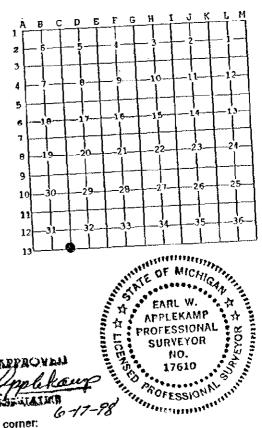

A. Description of original monument and accessories and/or subsequent restoration:

Original corner established by Austin Burt, U.S. Deputy Surveyor, August 29, 1845. Set wood post.

ORIGINAL BEARING TREES:

14" Hemlock 8" Sugar Maple

N37°E M18°W 11.22 feet 19.14 feet DEER GROUP VELYONPIT al W Spolkoup COURTE BESEIGNATION

6-17-98

B. Description of corner evidence found and/or method applied in restoring or reestablishing corner: No original evidence remains. In the mid 1940's Copper Range Cruisers marked the corner and subsequently it was tied to the Copper Range coordinate system. In early 1960's the area was stripped for borrow to construct a tailings dam. This altered the land greatly. I relocated the corners using the coordinates on record for the corner. This position fell in a large pond of water. I accepted the position and set two witness corners. The position of the corner is in conformance with the original field note calls. The corner is located at N34936.50 & E37033.35 Copper Range Coordinate System.

Research on file with the Ontonagon County Remonumentation Program Representative.

C. Description of monument for corner and accessories established to perpetuate locating the position of the corner:

Because the corner position falls in a pond, I set two witness corners on the Section Line recause the corner position rails in a pond, I set two witness corners on the Section Line West of the true corner. These monuments are 2½"x30" split base aluminum pipe, with a 3" stamped cap, the first witness monument is stamped, County Remonumentation, T51N R41W, W.M., S31, S32, N89°-25'-47"E, 673.43', 1998, P.S. 17610. The second Witness Monument w.M., S31, S32, N89°-25'-47"E, 673.43', 1998, P.S. 17610. The second Witness Monument w.M., S31, S32, N89°-25'-47"E, 673.43', 1998, P.S. 17610.

Nail in 6" Maple S00 w 17.06'		BEARING TREES FOR 2nd WITNESS MONUMENT Nail in 4" Maple S27°E 12.66' Nail in 10" Maple N73°W 11.90' Nail in 6" Maple N04°W 32.80'
Nail in 4" Maple N52°E 29.96 Signed by Lack W Applekaup Supporte Michigan License No.	<u> </u>	Date Date
Surveyor's Michigan License No.		
Salte) or a mine of		as shortestonal surveyors