APR 2 9 1996

COMMISSION

JUDITH D. ROEHM Ontonason Counts

47

LC

12/18/95

ounce 5 JEM Fee: :58 9,00

1

LAND CORNER RECORDATION CERTIFICATE

Page 1 of

Filing Requirement of Act 74, Mich. P.A. 1970

ONTONAGON Located In: Corner Code # 1. Public Land Survey _ R_40_ R_39 51 R 40 T T 51 R 39 _T __ _ B 2. Property Controlling _ _ T _ in Section R 3. Miscellaneous S Т Property in Section

Register of Deeds Stamp & File Number

4. Lot No. _____, Recorded Plat_

 
5. Private Claims

For corners in

Section Corner common to S1, 6, 31 & 36, T51 & 52N, R39 & 40W.

I, Earl W. Applekamp, in a field survey or August 19 , 19 95 , do hereby certify that under requirements of P.A. 74, Michigan P.A. of 1970, the corner points mentioned in lines 1 and 2 above were in conformance with regulations and rules therefore as required in the current manual of survey instructions of the United States Department of the Interior, Bureau of Land Management or by a decree of a Court of Law and/or that the corner points mentioned in lines 3, 4 and 5 above were in conformance with the rules of the Michigan Board of Professional Surveyors or by a Decree of a Court of Law; established, re-established, monumented, re-monumented, recovered, found as expressed below:

NOTE: Not more than 4 corners, all in the same town and range, may be recorded on this certificate.



Original corner established by William A. Burt, U.S. Deputy Surveyor, August 1845. Set Post.

ORIGINAL BEARING TREES:

Sugar 14" N17°E 42 links (27.72 feet) - 24" Hemlock N30°E 31 links (20.46 feet) Hemlock 18" S79°W 27 links (17.82 feet) - 16" Birch N18°W 20 links (13.20 feet)

B. Description of corner evidence found and/or method applied in restoring or reestablishing corner:

No original evidence found. At the corner position I found a 1½" pipe, pipe is identified in MDOT road plans for US-45. Pipe is also identified in the assessor's plat of Donnelly's subdivision No. 2, in the SW½ of Section 31, T52N R39W. Corner was used for Jones Subdivision of NW½ of Section 6, T51N R39W. Owner of the property at this corner, Jerry Koski, a Survey Technician, testified this corner has been there for many years and used for several surveys in the area. I accepted this position and monumented the corner as described below in "C".

Research on file.

C. Description of monument for corner and accessories established to perpetuate locating the position of the corner:

At the corner position I set a $2\frac{1}{2}$ "x30" aluminum pipe with a $3\frac{1}{4}$ " cap stamped to read: COUNTY REMONUMENTATION, T51 & 52N, R39 & 40W, S.1, S.6, S.31, S.36, 1995, P.S. 17610. I established the following bearing trees and reference objects:

10" Aspen N60°W 7" Aspen N25°E

12.85 feet - 12" Ash S74°E 17.81 feet 9.59 feet - Steel Sign Post. North 1.34 f

5" Maple S05°W

7.68 feet

- Steel Sign Post, North 1.34 feet

17.81 feet
North 1.34 feet

Date October 06, 1995

Surveyor's Michigan License No. 1761

FORM APPROVED BY MICHIGAN STATE BOARD OF PROFESSIONAL SURVEYORS, JAN. 28, 1971 REVISED MAY 14, 1975

_

PER APPOVED

REVISED JAN., 1983