

LAND CORNER RECORDATION CERTIFICATE
Filing Requirement of Act 74, Mich. P.A. 1970

For corners in
Ontonagon
(County)

Located in:

Corner Code #

1. Public Land Survey

T 52N R 40W

(K-10/11) #2

T R

T R

T R

2. Property Controlling
in Section

S T R

S T R

3. Miscellaneous

S T R

Property in Section

S T R

4. Lot No.

Recorded Plat

5. Private Claims

SURVEY &
REMONUMENTATION

MAY 22 1997

COMMISSION

Register of Deeds Stamp & File Number

I, Joseph C. Domitrovich, in a field survey on September 17, 19 96, do hereby certify that under requirements of P.A. 74, Michigan P.A. of 1970, the corner points mentioned in lines 1 and 2 above were in conformance with regulations and rules therefore as required in the current manual of survey instructions of the United States Department of the Interior, Bureau of Land Management or by a decree of a Court of Law and/or that the corner points mentioned in lines 3, 4 and 5 above were in conformance with the rules of the Michigan Board of Professional Surveyors or by a Decree of a Court of Law; established, re-established, monumented, re-monumented, recovered, found as expressed below:

NOTE: Not more than 4 corners, all in the same town and range, may be recorded on this certificate.

A. Description of original monument and accessories and/or subsequent restoration:

Meander Corner Sections 25 & 26, T52N, R 40W

1845 - William A. Burt set post

4" Spruce S 72° E 33 links

1923 - E. J. Donnelly, C.E., in old survey drawing on file with Ontonagon County Abstract and Title, shows the West line on Section 25 parallel with the East line of Section 25. He also established government lot lines parallel as shown in three Assessor's Plats in Section 25.

B. Description of corner evidence found and/or method applied in restoring or reestablishing corner:

The original corner and accessories have been destroyed by shoreline erosion.

I found the Southwest corner of Section 25 but no monumentation on the West Section line. Therefore, I re-established the West line of Section 25, parallel to the East line of Section 25. I established a witness corner to the Meander Corner at the Northerly end of said West line, 125 feet south of the water's edge.

Research on file with County Remonumentation Representative.

C. Description of monument for corner and accessories established to perpetuate locating the position of the corner:

Corner is a 3/4" x 72" aluminum rod with a 3" diameter aluminum cap stamped to read: County Remonumentation; M. C.; S. 26, S. 25; T 52N, R 40W; 1996; P.S. 37273. Corner falls at edge of treeline at shore of Lake Superior, 125 feet South of the edge of the water.


Witnesses:

13" Oak	S 48° E	8.27'
Steel Sign Post	South	0.67'
8" Oak	S 03° W	37.95'
8" Soft Maple	S 52° W	13.09'
14" Oak	N 30° W	9.29'

PEER GROUP APPROVED

Carl W. Applekamp
COUNTY REPRESENTATIVE

10-16-96

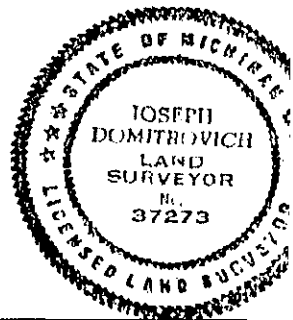

NOTE: Bearings are magnetic. Distances are to nail in side of witness objects unless noted.

Signed by J. C. Domitrovich

Date 10/15/96

Surveyor's Michigan License No. 37273

FORM APPROVED BY MICHIGAN STATE BOARD OF PROFESSIONAL SURVEYORS, JAN. 26, 1971
REVISED MAY 14, 1975
REVISED JAN., 1993

- SKETCH ON BACK -
215

T52N R40W

