

**LAND CORNER RECORDATION CERTIFICATE**  
**Filing Requirement of Act 74, Mich. P.A. 1970**

For corners in  
Presque Isle  
(County)

Located In:

Corner Code ##

1. Public Land Survey

T 33N R 2E

T      R     

T      R     

T      R     

2. Property Controlling  
in Section

S 17 T      R     

S      T      R     

3. Miscellaneous

S      T      R     

Property in Sec.

S      T      R     

8, 4, 3

Register of Deeds Stamp & File Number

4. Lot No.     , Recorded Plat     

5. Private Claims     

I, Carl R. Johnson, in a field survey on April 8, 19 91, do hereby certify that under requirements of P.A. 74, Michigan P.A. of 1970, the corner points mentioned in lines 1 and 2 above were in conformance with regulations and rules therefore as required in the current manual of survey instructions of the United States Department of the Interior, Bureau of Land Management or by a decree of a Court of Law and/or that the corner points mentioned in lines 3, 4 and 5 above were in conformance with the rules of the Michigan Board of Land Surveyors or by a Decree of a Court of Law; established, re-established, monumented, re-monumented, recovered, found as expressed below:

**NOTE: Not more than 4 corners, all in the same town and range, may be recorded on this certificate.**

A. Description of original monument and accessories and/or subsequent restoration:

8

4

3

B. Description of corner evidence found and/or method applied in restoring or reestablishing corner:

8

4

3

Corner established by standard  
survey procedure for  
subdivision of a section

Corner established by standard  
survey procedure for  
subdivision of a section

Corner established by standard  
survey procedure for  
subdivision of a section

C. Description of monument for corner and accessories established to perpetuate locating the position of the corner:

8

4

3

N1/8 Cor. on E-W 1/4 line

Set 5/8" bar w/cap

14" R. Pine S78 E 10.80'

14" Twin R. Pine S18 W 15.60'

14" R. Pine N87 W 25.84'

SE Cor. Block Bldg. N9 W 9.60'

(nail & tag in trees)

Center of NW 1/4

Set 5/8" bar w/cap

5" Balsam N21 W

4" W. Pine S54 E

2" Pipe S31 W

4" W. Pine N63 W

N1/8 Cor. on W. Side


Set 5/8" bar w/cap

5" Cedar N48 E 14.0'

5" Cedar S10 E 17.9'

3" pipe S20 W 12.7'

12" Cedar S34 W 9.9'

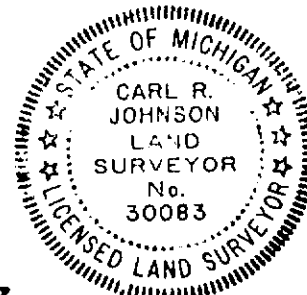

Signed by Carl R. Johnson  
Surveyor's Michigan License No. 30083

Date 1-6-92