

DEC 29 1999

LAND CORNER RECORDATION CERTIFICATE Filing Requirement of Act 74, Mich. P.A. 1970

SECTION

For corners in

Presque Isle
(County)

Located in:

Corner Code #

1. Public Land Survey

T4N R4E

E-11 ✓

2. Property Controlling
in Section

S

T R

3. Miscellaneous
Property in Sec.

S

T R

4. Lot No. _____, Recorded Plat _____

5. Private Claims _____

Recorded Dec 16, 1999
At 11:30 o'clock A.M.
Janet M. Lamb
Reg. of Deeds, Presque Isle Co. MI

Register of Deeds Stamp & File Number

I, Ronald Bischer, in a field survey on Aug. 20, 1999 do hereby state that under requirements of P.A. 74, Michigan P.A. of 1970, the corner points mentioned in lines 1 and 2 above were in conformance with regulations and rules therefore as required in the current manual of survey instructions of the United States Department of the Interior, Bureau of Land Management or by a decree of a Court of Law and/or that the corner points mentioned in lines 3, 4 and 5 above were in conformance with the rules of the Michigan Board of Land Surveyors or by a Decree of a Court of Law, established, re-established, monumented, recovered, found as expressed below:

NOTE: Not more than 2 corners, all in the same town and range, may be recorded on this certificate.

	A	B	C	D	E	F	G	H	I	J	K	L	M
1													
2	6		5		4		3		2		1		
3													
4	7		8		9		10		11		12		
5													
6	18		17		16		15		14		13		
7													
8	19		20		21		22		23		24		
9													
10	30		29		28		27		26		25		
11													
12	31		32		33		34		35		36		
13													

A. Description of original monument and accessories and/or subsequent restoration:

E-11

1856 GLO Notes

S70°W 12 lks 10" Aspen

N65°E 36 lks 10" Maple

Oct. 25, 1973 Delmer Porter #15410
found 1" pipe in intersection

S40°W 111.40' 14" Oak

S30°E 77.55' 18" Oak N30°E 62.20' 10" Oak Set 2 new witnesses

B. Description of corner evidence found and/or method applied in restoring or reestablishing corner:

E-11

Aug. 20, 1999 Presque Isle County Remonumentation

Ronald Bischer #22428

1/2" rod and cap #22428 in mon box

found four witnesses

SAug. 30, 1978 Delmer Porter #15410
1/2" rod in mon box
Same witnesses as above
Aug 22, 1983 Delmer Porter #15410
Same as above
March 25, 1994 Ronald Bischer #22428
1/2" rod and cap in mon box
found 2 old witnesses

C. Description of monument for corner and accessories established to perpetuate locating the position of the corner:

E-11

1/2" rod and cap #22428 in mon box

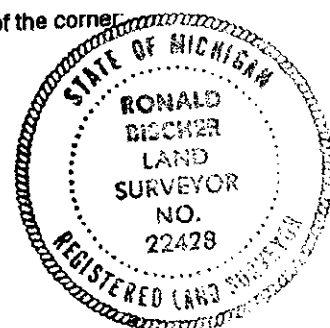
S36°E 76.58' 24" Oak

S44°W 51.50' 6" Maple

N05°E 40.73' 12" Aspen

N47°E 63.64' 10" Oak

Ratified by Peer Group
in accordance with P.A. 345

Chairman Norman J. DavisDate 11/30/99

Signed by

Ronald R. Bischer

Surveyor's Michigan License No.

22428Date 12-13-99