

SECTION

LAND CORNER RECORDATION CERTIFICATE
Filing Requirement of Act 74, Mich. P.A. 1970

For corners in

Presque Isle
(County)

Located In:

Corner Code #

1. Public Land Survey

T 34N R 4E

F-13 ✓

2. Property Controlling
in Section

S

T R

3. Miscellaneous
Property in Sec.

S

T R

4. Lot No. _____, Recorded Plat _____
5. Private Claims _____

I, Ronald Bischer, in a field survey on Aug 20, 1999 do hereby state that under requirements of P.A. 74, Michigan P.A. of 1970, the corner points mentioned in lines 1 and 2 above were in conformance with regulations and rules therefore as required in the current manual of survey instructions of the United States Department of the Interior, Bureau of Land Management or by a decree of a Court of Law and/or that the corner points mentioned in lines 3, 4 and 5 above were in conformance with the rules of the Michigan Board of Land Surveyors or by a Decree of a Court of Law; established, re-established, monumented, recovered, found as expressed below:

NOTE: Not more than 2 corners, all in the same town and range, may be recorded on this certificate.

A. Description of original monument and accessories and/or subsequent restoration:

F-13

1840 GLO Notes

N82°E 18 lks 18" Pine

N62°W 32 lks 6" Pine

1970 Delmer Porter #15410

Conc. Mon.

N56°W 5.20' 8" Oak

S42°E 10.87' 7" Oak

S06°E 18.43' 7" Oak

B. Description of corner evidence found and/or method applied in restoring or reestablishing corner:

F-13

Aug. 20, 1999 Presque Isle County Remonumentation

Ronald Bischer #22428

Found conc. mon and 4 witnesses

June 17, 1999 Ronald Bischer #22428
Set conc. mon.
N48°W 14.28' 10" Oak
N61°E 14.02' 10" Oak
S22°E 16.97' 9" Oak
South 26.45' 12" Oak
reset according to 1/8th corners of
section measurements

C. Description of monument for corner and accessories established to perpetuate locating the position of the corner

F-13

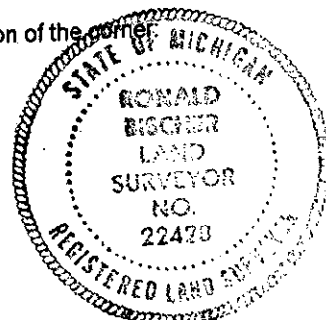
Conc. Mon

N48°W 14.28' 10" Oak

N61°E 14.02' 10" Oak

S22°E 16.97' 9" Oak

South 26.45' 12" Oak

Ratified by Peer Group
in accordance with P.A. 345Chairman Norman J. RuaneDate 11/30/99Signed by Ronald R. Bischer
Surveyor's Michigan License No. 22428Date 12-13-99