

2514

1998 PRESQUE ISLE COUNTY, STATE OF MICHIGAN REMONUMENTATION

LAND CORNER RECORDATION CERTIFICATE
Filing Requirement of Act 74, Mich. P.A. 1970

For corners in

Presque Isle
(County)

Located In:

Corner Code #

1. Public Land Survey T 34N R 4E G-10
 T R _____
 T R _____
 T R _____
 T R _____
2. Property Controlling S _____
 in Section S _____
3. Miscellaneous S _____
 Property in Sec. S _____

PRESQUE ISLE COUNTY
RECORDED

98 DEC 17 PM 4: 26

Janet M. Lamb
REGISTER OF DEEDS

Register of Deeds Stamp & File Number

4. Lot No. _____, Recorded Plat _____
5. Private Claims _____

I, Delmer E. Porter, in a field survey on Jan. 9, 1998 do hereby state that under requirements of P.A. 74, Michigan P.A. of 1970, the corner points mentioned in lines 1 and 2 above were in conformance with regulations and rules therefore as required in the current manual of survey instructions of the United States Department of the Interior, Bureau of Land Management or by a decree of a Court of Law and /or that the corner points mentioned in lines 3, 4 and 5 above were in conformance with the rules of the Michigan Board of Land Surveyors or by a Decree of a Court of Law, established, re-established, monumented, recovered, found as expressed below:

NOTE: Not more than 2 corners, all in the same town and range, may be recorded on this certificate.

	A	B	C	D	E	F	G	H	I	J	K	L	M
1													
2		6		5		4		3		2		1	
3													
4		7		8		9		10		11		12	
5													
6		18		17		16		15		14		13	
7													
8		19		20		21		22		23		24	
9													
10		30		29		28		27		26		25	
11													
12		31		32		33		34		35		36	
13													

A. Description of original monument and accessories and/or subsequent restoration:

G-10 GLO NOTES
June 27, 1856
Set Quarter Sec Post
Beech 8 S35W 20 Links
Beech 14 N15E 25 Links

SURVEY &
REMONUMENTATION

JAN 14 1999

SECTION

B. Description of corner evidence found and/or method applied in restoring or reestablishing corner:


G-10 1" Pipe
N41°W 66.73' 12" Pine

Ratified by Peer Group
in accordance with P.A. 345

Chairman *Norman J. Quam*
Date 12/17/98

C. Description of monument for corner and accessories established to perpetuate locating the position of the corner:

G-10 1" Pipe
N41°W 66.07' 15" Spruce
N88°E 35.35' Fence Post
S72°E 35.20' 10" J. Pine
S74°W 58.28' 5" J. Pine
N90°W 33.12' 1/2" Rod & Cap #22429

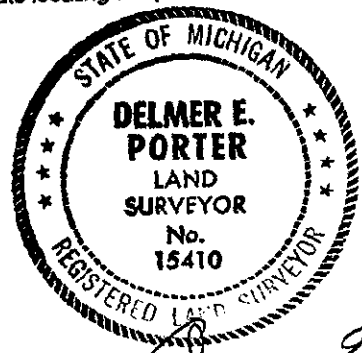

Signed by *Delmer E. Porter*
Surveyor's Michigan License No. #15410

Date Dec 9, 1998