

1993

PRESQUE ISLE COUNTY  
RECORDED

COMM

## LAND CORNER RECORDATION CERTIFICATE

93 DEC 22 AM 10:01

Filing Requirement of Act 74, Mich. P.A. 1970

For corners in

PRESQUE ISLE

(County)

Located In:

Corner Code #

*Janet M. Lamb*  
REGISTER OF DEEDS

1. Public Land Survey

T 34N R 2E

C-12

T \_\_\_\_\_ R \_\_\_\_\_

T \_\_\_\_\_ R \_\_\_\_\_

T \_\_\_\_\_ R \_\_\_\_\_

2. Property Controlling  
in Section

S \_\_\_\_\_ T \_\_\_\_\_ R \_\_\_\_\_

S \_\_\_\_\_ T \_\_\_\_\_ R \_\_\_\_\_

3. Miscellaneous  
Property in Sec.

S \_\_\_\_\_ T \_\_\_\_\_ R \_\_\_\_\_

S \_\_\_\_\_ T \_\_\_\_\_ R \_\_\_\_\_

Register of Deeds Stamp &amp; File Number

4. Lot No. \_\_\_\_\_, Recorded Plat \_\_\_\_\_

5. Private Claims \_\_\_\_\_

I, DELMER E. PORTER field survey on SEPT. 25, 19 93,  
do hereby certify that under requirements of P.A. 74, Michigan P.A. of 1970, the corner points mentioned  
in lines 1 and 2 above were in conformance with regulations and rules therefore as required in the  
current manual of survey instructions of the United States Department of the Interior, Bureau of Land  
Management or by a decree of a Court of Law and/or that the corner points mentioned in lines 3, 4 and 5  
above were in conformance with the rules of the Michigan Board of Land Surveyors or by a Decree of a  
Court of Law; established, re-established, monumented, re-monumented, recovered, found as  
expressed below:

NOTE: Not more than 4 corners, all in the same town and range, may be recorded  
on this certificate.

A. Description of original monument and accessories and/or subsequent restoration:

C-12 GLO NOTES

JULY 18, 1855

SUGAR 20" N 30° E 19 ½ lks.

BEECH 8" S 18° W 28 lks.

WITNESSES

N 45° W 57.59'

SIGN POST

S 40° W 74.85'

POWER POLE

S 45° E 40.58'

FENCE CORNER

C-12 P.A. 74 FILED BY DELMER E. PORTER

AUG. 9, 1974 PAGE 59 LAND CORNER

RECORDS

FOUND 1" AXLE SHAFT

B. Description of corner evidence found and/or method applied in restoring or reestablishing corner:

C-12

FOUND 1" AXLE SHAFT

N 45° E 57.59' SIGN POST

S 40° W 74.85' P. POLE

S 45° E 40.58' FENCE CORNER

Ratified by Peer Group  
in accordance with P.A. 345Chairman *Delmer E. Porter*Date December 14, 1993

C. Description of monument for corner and accessories established to perpetuate locating the position of the corner:

C-12

1" AXLE SHAFT

S 52° W 32.32' 3" ELM


N 15° W 116.80' 7" APPLE

S 71° E 115.73' 4" ELM

S 13° W 175.26' 4" ELM

\* NAILS AND TAGS #15410 USED IN WITNESSES

PORTER'S SURVEY, P.C.

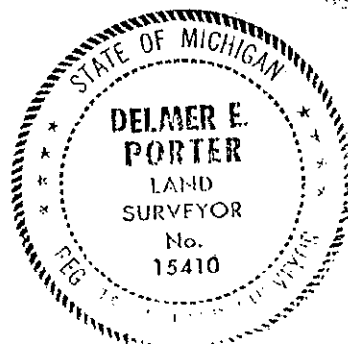

Signed by

*Delmer E. Porter*

Date

Dec 20, 1993Surveyor's Michigan License No. 15410

# CORNER HISTORY RESEARCH SHEET

C-12

T34N,R2E ALLIS TOWNSHIP-NORTH PART,  
PRESQUE ISLE COUNTY, MICHIGAN.

## ACTIVITY MONUMENT & ACCESSORIES - COMMENTS

GLO Survey July 18, 1855	Sugar 20" N30°E 19 1/2 Links Beech 8" S18°W 28 Links
M.D.S.H. July 1961 Lyle Schalzried, Survey Chief	Fd. 1" <u>Ankle</u> Shaft 1" below surface N73°E Route-Marker 50.90' N26°E Route-Marker 46.78' S87°W Iron Pet Gas Sign 31.95'
M.D.S.H. June 1962 Gordon Slattery	2"x4' Axle Shaft /5" Hub in Centerline of road on North-South Fence Line N55°E 105.39' 5" Maple N30°E 89.73' 10" Maple S02°W 33.94' End Fe. Post
Act 132 Survey by: Porter's Survey Aug.8, 1974, Survey#72-74, Recorded, Lib.206, Pg.806	Assessories same as above
Act 74 filing by: Delmer E. Porter #15410, Aug.9, 1974 Page 59, Corner Recordation	Fd. 1" Rod Left Same N45°W 57.59' Sign Post S40°W 74.85' P. Pole S45°E 40.58' Fe. Cor
Act 132 Survey by: Porter's Survey Aug.8, 1975, Survey#75-75, Recorded Lib. Pg.	Assessories Same as above
Act 132 Survey by: Porter's Survey Sept.25, 1980, Survey#114-80, Recorded Lib.241, Pg.195	Assessories Same as above
Act 132 Survey by: Porter's Survey May 2, 1989, Survey#37-89 Unrecorded	Assessories Same as above
Remonumentation Sept.25, 1993	Fd. 1" Rod N45°E 57.59' Sign Post (Fd.) S40°W 74.85' P. Pole (Fd.) S45°E 40.58' Fe. Cor. (Fd.) Left Same S52°W 32.32' 3" Elm (New) N15°W 116.80' 7" Apple (New) S71°E 115.73' 4" Elm (New) S13°W 175.26' 4" Elm (New)

JAN 22 2001

SECTION

#3