

PRESQUE ISLE COUNTY  
RECORDED

93 DEC 22 AM 10:02

LAND CORNER RECORDATION CERTIFICATE  
Filing Requirement of Act 74, Mich. P.A. 1970*Janet M. Lamb*  
REGISTER OF DEEDS

For corners in

PRESQUE ISLE  
(County)

Located In:

Corner Code #

1. Public Land Survey T 34 R 2E E-7  
T \_\_\_\_\_ R \_\_\_\_\_  
T \_\_\_\_\_ R \_\_\_\_\_  
T \_\_\_\_\_ R \_\_\_\_\_  
2. Property Controlling S \_\_\_\_\_ T \_\_\_\_\_ R \_\_\_\_\_  
in Section S \_\_\_\_\_ T \_\_\_\_\_ R \_\_\_\_\_  
3. Miscellaneous S \_\_\_\_\_ T \_\_\_\_\_ R \_\_\_\_\_  
Property in Sec. S \_\_\_\_\_ T \_\_\_\_\_ R \_\_\_\_\_

Register of Deeds Stamp &amp; File Number

4. Lot No. \_\_\_\_\_, Recorded Plat \_\_\_\_\_  
5. Private Claims \_\_\_\_\_

I, DELMER E. PORTER field survey on SEPT. 25, 19 93,  
do hereby certify that under requirements of P.A. 74, Michigan P.A. of 1970, the corner points mentioned  
in lines 1 and 2 above were in conformance with regulations and rules therefore as required in the  
current manual of survey instructions of the United States Department of the Interior, Bureau of Land  
Management or by a decree of a Court of Law and/or that the corner points mentioned in lines 3, 4 and 5  
above were in conformance with the rules of the Michigan Board of Land Surveyors or by a Decree of a  
Court of Law; established, re-established, monumented, re-monumented, recovered, found as  
expressed below:

NOTE: Not more than 4 corners, all in the same town and range, may be recorded  
on this certificate.

## A. Description of original monument and accessories and/or subsequent restoration:

E-7 GLO NOTES  
JULY 13. 1855  
SUGAR 16" N 45° W 45 lks.  
BEECH 20" S 50° E 28 lks.

## WITNESSES

N 47° W 49.00' POWER POLE  
S 37° E 50.91' POWER POLE  
S 04° W 34.52' FENCE CORNER

E-7  
P.A. 74 FILING BY RONALD R. BISCHER  
L.S. #22428 OCT. 1976 RECORDED PG.9  
LAND CORNER RECORDS

## B. Description of corner evidence found and/or method applied in restoring or reestablishing corner:

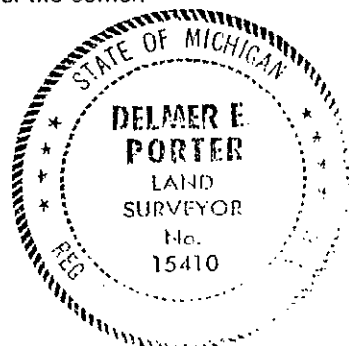
E-7 SEPT. 25. 1993  
FOUND  $\frac{1}{2}$ " ROD IN MONUMENT BOX  
N 47° W 49.00' POWER POLE  
S 37° E 50.91' POWER POLE  
S 04° W 34.52' FENCE CORNER  
LEFT SAME  
SET CAP #15410 ON  $\frac{1}{2}$ " ROD

Ratified by Peer Group  
in accordance with P.A. 345

Chairman *Delmer E. Porter*  
Date December 14, 1993

## C. Description of monument for corner and accessories established to perpetuate locating the position of the corner:

E-7  
 $\frac{1}{2}$ " ROD AND CAP #15410 IN MONUMENT BOX  
S 09° E 49.16' 8" SCOTCH PINE  
N 42° W 109.48' SE CORNER OF TOWNSHIP HALL  
N 85° E 119.25' 8" ELM  
S 64° E 144.69' 26" MAPLE  
\* NAILS AND TAGS #15410 USED ON WITNESSES  
PORTER'S SURVEY, P.C.

Signed by *Delmer E. Porter*Date Dec 20, 1993Surveyor's Michigan License No. 15410

# CORNER HISTORY RESEARCH SHEET

E-7

T34N,R2E ALLIS TOWNSHIP-NORTH PART,  
PRESQUE ISLE COUNTY, MICHIGAN.

## ACTIVITY      MONUMENT & ACCESSORIES      COMMENTS

GLO Survey  
July 13, 1855

Sugar 16" N45°W 45 Links  
Beech 20" S50°E 28 Links

Act 74 filing by:  
Ronald R. Bischer  
#22428, Oct. 26, 1976,  
Page 9, Corner  
Recordation

Fd. 1/2" Rod & Cap in Mon Box  
Left Same  
N47°W 49.00' P. Pole  
S37°E 50.91' P. Pole  
S04°W 34.52' Fe. Cor.

Act 132 Survey by:  
Delmer E. Porter,  
#15410, May 11, 1984,  
1984, Survey#38-84,  
File#34R2154  
Lib.258, Pg.463 &  
Lib.258, Pg.464

Fd. Same as above

Act 132 Survey by:  
Delmer E. Porter,  
#15410, Dec.7, 1985,  
Survey#66-85  
File#34R2176  
Lib.      Pg.

Fd. Same as above

Act 132 filing by:  
Delmer E. Porter  
#15410, Mar.27, 1987,  
Survey#22-87  
File#34R2196  
Not Recorded

Fd. Same as above

Act 132 Survey by:  
Delmer E. Porter  
#15410, July 6, 1989,  
Survey#66-89  
Not Recorded

Fd. 1/2" Rod & Cap in Mon. Box  
S04°W 34.52' Fe. Cor. (Fd.)  
N81°E 103.60' P. Pole  
N41°W 109.21' SE Gr. Bld.  
N69°W 162.90' P. Pole

Remonumentation  
Sept 25, 1993

Fd. 1/2" Rod & Cap  
#15410 in Mon. Box  
N47°W 49.00' P. Pole (Fd.)  
S37°E 50.91' P. Pole (Fd.)  
S04°W 34.52' Fe. Cor. (Fd.)  
Left Same  
S09°E 49.16' 8" Scotch  
N42°W 109.48' SE Cor. Twp. Hall  
N85°E 119.25' 8" Elm  
S64°E 144.69' 26" Maple

*[Handwritten signature]*