

1993

COMMIS...

PRESQUE ISLE COUNTY
RECORDED

93 DEC 22 AM 10:00

LAND CORNER RECORDATION CERTIFICATE

Filing Requirement of Act 74, Mich. P.A. 1970

For corners in

PRESQUE ISLE
(County)

Located In:

Corner Code #

1. Public Land Survey

T 34N R 2E

E-9

T R

T R

T R

2. Property Controlling
in Section

S T R

S T R

3. Miscellaneous

S T R

Property in Sec.

S T R

4. Lot No. , Recorded Plat

5. Private Claims

Jesse M. Lamb
REGISTER OF DEEDS

Register of Deeds Stamp & File Number

1. DELMER E. PORTER in a field survey on SEPT. 12, 1993,
do hereby certify that under requirements of P.A. 74, Michigan P.A. of 1970, the corner points mentioned
in lines 1 and 2 above were in conformance with regulations and rules therefore as required in the
current manual of survey instructions of the United States Department of the Interior, Bureau of Land
Management or by a decree of a Court of Law and/or that the corner points mentioned in lines 3, 4 and 5
above were in conformance with the rules of the Michigan Board of Land Surveyors or by a Decree of a
Court of Law; established, re-established, monumented, re-monumented, recovered, found as
expressed below:

NOTE: Not more than 4 corners, all in the same town and range, may be recorded
on this certificate.

A. Description of original monument and accessories and/or subsequent restoration:

E-9 GLO NOTES, JULY 16, 1855

BEECH 16" S 50° E 24 lks.

E-9

P.S. 74 FILING BY DELMER E. PORTER

L.S. #15410 MAY 1, 1974 PAGE 45 LAND CORNER FOUND 1/2" ROD AND CAP #15410

RECORDS. FOUND R.R. RAIL BY OLS STAKE ,

RAISED WITH 1/2" RODS & CAP #15410

N 40° W 58.01' 26" ELM

N 40° E 54.76' 6" APPLE

S 25° W 36.04' FENCE CORNER

E-9

P.A. 74 FILING BY NORMAN J. QUAIN

L.S. #33984 APRIL 22, 1992 PG. 84

LAND CORNER RECORDS

FOUND 1/2" ROD AND CAP #15410

N 40° E 54.76' 6" APPLE

S 45° W 48.81' FENCE POST

S 23° E 39.66' FENCE POST

SOUTH 33.80' FENCE CORNER

B. Description of corner evidence found and/or method applied in restoring or reestablishing corner:

E-9

SEPT 12, 1993

FOUND 1/2" ROD & CAP #15410

N 40° E 54.76' 6" MAPLE (STUMP)

S 45° W 48.81' FENCE POST

S 23° E 39.66' FENCE POST

SOUTH 33.80' FENCE CORNER

LEFT SAME

Ratified by Peer Group
in accordance with P.A. 345Chairman Delmer E. PorterDate December 18, 1993

C. Description of monument for corner and accessories established to perpetuate locating the position of the corner:

E-9

1/2" ROD AND CAP #15410

N 69° E 74.34' 5" IRONWOOD

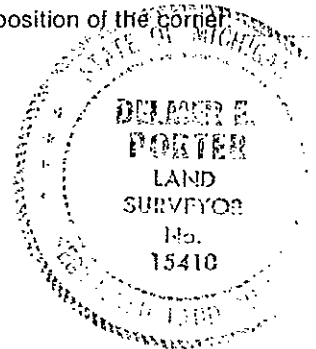
N 40° E 38.90' 4" MAPLE

N 08° W 34.62' 6" MAPLE

S 27° W 63.50' 5" RED PINE

* NAILS AND TAGS #15410 USED ON WITNESSES

PORTER'S SURVEY P.C.

Signed by Delmer E. PorterDate Dec 20, 1993Surveyor's Michigan License No. 15410

CORNER HISTORY RESEARCH SHEET

E-9

T34N,R2E ALLIS TOWNSHIP-NORTH PART,
PRESQUE ISLE COUNTY, MICHIGAN.

ACTIVITY MONUMENT & ACCESSORIES - COMMENTS

GLO Survey July 16, 1855	Beech 16" S50°E 24 Links Beech 16" S78°W 24 Links
Act 74 filing by: Delmer E. Porter, #15410, May 1, 1974, Page 45, Corner Recordation	Fd. R.R. Rail by old stake Buried 2', 10' East of Fe. Cor. Raised w/ 1/2" Rod & Cap #15410 N40°W 58.01' 26" Elm N40°E 54.76' 6" Apple S25°W 36.04' Fe. Cor.
Act 132 Survey by: Delmer E. Porter, #15410, Apr.30, 1974, Survey#30-74 Lib. 205, Pg. 167	Same as above
Act 132 Survey by: Delmer E. Porter, #15410, Sept.2, 1976, Survey#129-76 File#34R2082 Lib. Pg.	1/2" Rod & Cap #15410 N50°W 57.95' 33" Elm N65°E 54.81' 12" Apple S20°W 36.13' Fe. Post
Act 132 Survey by: Delmer E. Porter, #15410, Sept.25, 1980, Survey#89-80 File#34R2117 Lib. Pg.	Same as recorded in 1974
Act 132 Survey by: Delmer E. Porter, #15410, Aug.8, 1984, Survey#73-84 File#34R2159 Lib. Pg.	Same as recorded in 1974
Act 132 Survey by: Delmer E. Porter, #15410, May 5, 1986, Survey#21-86 File#34R2187 Lib. Pg.	Same as recorded in 1974
Act 132 Survey by: Delmer E. Porter, #15410, Apr.13, 1990, Survey#168-89 File#34R2233 Unrecorded	1/2" Rod & Cap #15410 N50°W 57.95' 33" Elm N65°E 54.81' 12" Apple S20°W 36.13' Fe. Post
Act 74 filing by: Norman J. Quaine, #33984, April 22, 1992 Page 847, Corner Recordation	Fd. 1/2" Rod & Cap #15410 N40°E 54.76' 6" Apple Left Same N40°E 54.76' 6" Apple S45°W 48.81' Fe. Post S23°E 39.66' Fe. Post South 33.80' Fe. Cor.

JAN 22 2001

SECTION