

93 DEC 20 PM 4:49

LAND CORNER RECORDATION CERTIFICATE
Filing Requirement of Act 74, Mich. P.A. 1970

For corners in

PRESQUE ISLE
(County)

Located In:

Corner Code ##

John M. Lamb
REGISTER OF DEEDS

1. Public Land Survey	T <u>34N</u> R <u>2E</u>	<u>G-6</u>
	T _____ R _____	_____
	T _____ R _____	_____
	T _____ R _____	_____
2. Property Controlling in Section	S _____ T _____ R _____	_____
	S _____ T _____ R _____	_____
3. Miscellaneous Property in Sec.	S _____ T _____ R _____	_____
	S _____ T _____ R _____	_____

LIBER 307 PAGE 932

Register of Deeds Stamp & File Number

4. Lot No. _____, Recorded Plat _____
5. Private Claims _____

I, Ronald R. Bischer, in a field survey on September 14, 19 93,
do hereby certify that under requirements of P.A. 74, Michigan P.A. of 1970, the corner points mentioned
in lines 1 and 2 above were in conformance with regulations and rules therefore as required in the
current manual of survey instructions of the United States Department of the Interior, Bureau of Land
Management or by a decree of a Court of Law and/or that the corner points mentioned in lines 3, 4 and 5
above were in conformance with the rules of the Michigan Board of Land Surveyors or by a Decree of a
Court of Law; established, re-established, monumented, re-monumented, recovered, found as
expressed below:

NOTE: Not more than 4 corners, all in the same town and range, may be recorded
on this certificate.

A. Description of original monument and accessories and/or subsequent restoration:

G-6

1855 Resurvey - Geo. H. Cannon (July)

Set Wood Post

17" Elm N55°W 30 links

9" Beech S79°E 28 links

1975 - Delmar E. Porter

Found 1-½" Pipe in road intersection

N59°W 22.18' 20" Elm

S58°W 33.38' Telephone pole

S40°E 44.23' Power pole

Recorded on Page 84, Land

Recordation, August 18, 1975.

B. Description of corner evidence found and/or method applied in restoring or reestablishing corner:

G-6

Found 1-½" Pipe

S58°W 33.38' Telephone pole


S43°E 44.17' Power pole

Raised 1-½" Pipe with ½" Rod and Cap #22428.

SURVEY &
REMONUMENTATION

1993

COMMISSION

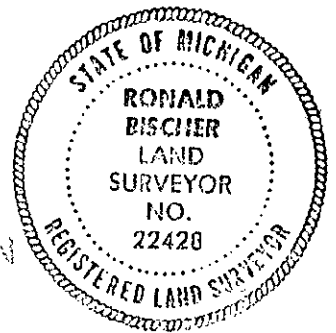

C. Description of monument for corner and accessories established to perpetuate locating the position of the corner:

G-6

½" Rod and Cap #22428 in 1-½" Pipe

S58°W 33.38' Telephone pole

S43°E 44.17' Power pole

N89°W 33.02' ½" Rod and Cap #15410

N49°E 66.08' 5" Ironwood

*Witness tags and nails used.

Ratified by Peer Group
in accordance with P.A. 345Chairman *Delmar E. Porter*Date December 7, 1993Signed by Ronald R. BischerDate 12-13-93Surveyor's Michigan License No. 22428

CORNER HISTORY RESEARCH SHEET

LIBER 307 PAGE 933

G-6 Corner, Section 15 & 16, Township 34N Range 2E

<u>Activity</u>	<u>Monument & Accessories</u>	<u>Notes</u>
1855 Resurvey Geo. H. Cannon	Set Wood Post 17" Elm N55°W 30 links 9" Beech S79°E 28 links	
1975 Delmar E. Porter #15410	Found 1-½" Pipe in road intersection. Set three witnesses. Recorded on Page 84, Land Recordation, August 18, 1975.	
1993 Remonumentation Ronald R. Bischer #22428	Found 1-½" Pipe, raised w/½" Rod and Cap #22428 S58°W 33.38' Telephone pole found nail w/tag #15410 S43°E 44.17' Power pole found nail w/tag #15410 N89°W 33.02' ½" Rod & cap #15410 N49°E 66.08' 5" Ironwood set nail w/tag #22428	N59°W 22.18' 20" Elm witness is dead - rotten stump remains.

A3