

93 DEC 20 PM 4: 50

LAND CORNER RECORDATION CERTIFICATE
Filing Requirement of Act 74, Mich. P.A. 1970

For corners in

PRESQUE ISLE
(County)

Located In:

Corner Code ##

1. Public Land Survey T 34N R 2E I-2
T _____ R _____
T _____ R _____
T _____ R _____
2. Property Controlling S _____ T _____ R _____
in Section S _____ T _____ R _____
3. Miscellaneous S _____ T _____ R _____
Property in Sec. S _____ T _____ R _____

James M. Lamb
REGISTER OF DEEDS

LIBER 307 PAGE 946

Register of Deeds Stamp & File Number

4. Lot No. _____, Recorded Plat _____
5. Private Claims _____

I, Ronald R. Bischer, in a field survey on September 20, 19 93, do hereby certify that under requirements of P.A. 74, Michigan P.A. of 1970, the corner points mentioned in lines 1 and 2 above were in conformance with regulations and rules therefore as required in the current manual of survey instructions of the United States Department of the Interior, Bureau of Land Management or by a decree of a Court of Law and/or that the corner points mentioned in lines 3, 4 and 5 above were in conformance with the rules of the Michigan Board of Land Surveyors or by a Decree of a Court of Law, established, re-established, monumented, re-monumented, recovered, found as expressed below:

NOTE: Not more than 4 corners, all in the same town and range, may be recorded on this certificate.

A. Description of original monument and accessories and/or subsequent restoration:

I-2

1855 Resurvey - Geo. H. Cannon (July)

Set Wood Post

9" Cedar S60°E 12 links

13" Cedar N70°W 10 links

1988 - Ronald R. Bischer

Set ½" Rod by Single Proportion

Corner was recorded, but later

moved.

1992 - Delmar E. Porter

Set ½" Rod and Cap #15410 by single proportion

S14°W 5.84' 12" Cedar

S78°E 25.44' 10" Cedar

S65°E 24.30' 6" Cedar

N89°E 29.86' 6" Cedar (Not recorded)

B. Description of corner evidence found and/or method applied in restoring or reestablishing corner:

I-2

Found ½" Rod and Cap #15410

S14°W 5.84' 12" Cedar

S78°E 25.44' 10" Cedar


S65°E 24.30' 6" Cedar

N89°E 29.86' 6" Cedar

RE-MONUMENTATION

1993

COMMISSION

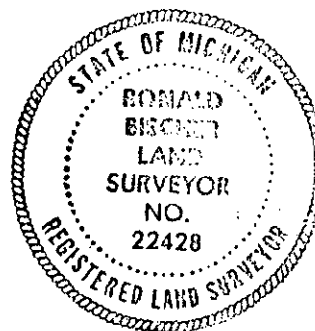

Pulled ½" Rod and Cap #22428, 22.13' North.

C. Description of monument for corner and accessories established to perpetuate locating the position of the corner:

I-2

½" Rod and Cap #15410

S14°W 5.84' 12" Cedar

S78°E 25.44' 10" Cedar

S65°E 24.30' 6" Cedar

N89°E 29.86' 6" Cedar

Ratified by Peer Group
in accordance with P.A. 345Chairman *Delmar E. Porter*Date December 7, 1993

*Witness tags and nails used.

Signed by Ronald R. BischerDate 12-13-93Surveyor's Michigan License No. 22428

CORNER HISTORY RESEARCH SHEET

LIBER 307 PAGE 947

I-2 Corner, Section 2, 3, Township 34N Range 2E

<u>Activity</u>	<u>Monument & Accessories</u>	<u>Notes</u>
1855 Resurvey Geo. H. Cannon	Set Wood Post 9" Cedar S60°E 12 links 13" Cedar N70°W 10 links	
1988 Ronald R. Bischer #22428	Set ½" Rod & Cap #22428 by single proportion Set three witnesses. Recorded on Page 748, Land Recordation, October 25, 1988.	
1992 Delmar E. Porter #15410	Set ½" Rod & Cap #15410 by single proportion Set four witnesses (Not recorded)	
1993 Remonumentation Ronald R. Bischer #22428	Found ½" Rod & Cap #15410, pulled ½" Rod & Cap #22428 22.13' North. S14°W 5.84' 12" Cedar found nail w/tag #15410 S78°E 25.44' 10" Cedar found nail w/tag #15410 S65°E 24.30' 6" Cedar found nail w/tag #15410 N89°E 29.86' 6" Cedar found nail w/tag #15410	

#5'