

1993

PRESQUE ISLE COUNTY
RECORDED

93 DEC 22 AM 10:04

COMMISSION

LAND CORNER RECORDATION CERTIFICATE
Filing Requirement of Act 74, Mich. P.A. 1970*Janet M. Lamb*
REGISTER OF DEEDS

For corners in

PRESQUE ISLE
(County)

Located In:

Corner Code #

1. Public Land Survey	T	<u>34N</u>	R	<u>2E</u>	<u>J-13</u>
	T		R		
	T		R		
	T		R		
2. Property Controlling	S		T	R	
in Section	S		T	R	
3. Miscellaneous	S		T	R	
Property in Sec.	S		T	R	

Register of Deeds Stamp & File Number

4. Lot No. _____, Recorded Plat _____

5. Private Claims _____

I, DELMER E. PORTER, in a field survey on SEPT. 13, 19 93, do hereby certify that under requirements of P.A. 74, Michigan P.A. of 1970, the corner points mentioned in lines 1 and 2 above were in conformance with regulations and rules therefore as required in the current manual of survey instructions of the United States Department of the Interior, Bureau of Land Management or by a decree of a Court of Law and/or that the corner points mentioned in lines 3, 4 and 5 above were in conformance with the rules of the Michigan Board of Land Surveyors or by a Decree of a Court of Law; established, re-established, monumented, re-monumented, recovered, found as expressed below:

NOTE: Not more than 4 corners, all in the same town and range, may be recorded on this certificate.

A. Description of original monument and accessories and/or subsequent restoration:

J-13 GLO NOTES
JULY 3, 1855
CEDAR 10" N 25° E 101ks.
CEDAR 10" N 49° W 29 lks.

J-13
P.A. 74 FILED BY RONALD R. BISCHER
L.S. #22428 JULY 13, 1982, PAGE 604
LAND CORNER RECORDS

½" ROD IN ROAD ESTABLISHED
ROADWAY AT FENCELINE TO NORTH
S 08° E 36.79' 14" SPRUCE
N 46° W 89.50' 12" N. PINE
N 02° E 33.18' FENCE CORNER

B. Description of corner evidence found and/or method applied in restoring or reestablishing corner:


J-13
SEPT. 13, 1993
FOUND ½" ROD IN ROAD
N 45° W 89.57' 18" W. PINE
S 03° E 37.01' 18" SPRUCE
PLACED CAP #15410 on rod

Ratified by Peer Group
in accordance with P.A. 346

Chairman *Delmer E. Porter*
Date December 18, 1993

C. Description of monument for corner and accessories established to perpetuate locating the position of the corner:

J-13
½" ROD & CAP 315410
N 45° W 89.57' 18" W. PINE
N 37° E 87.75' 18" SPRUCE
S 03° E 37.01' 19" SPRUCE
S 65° W 74.01' 6" CEDAR
* NAILS AND TAGS #15410 USED ON WITNESSES
PORTER'S SURVEY, P.C.

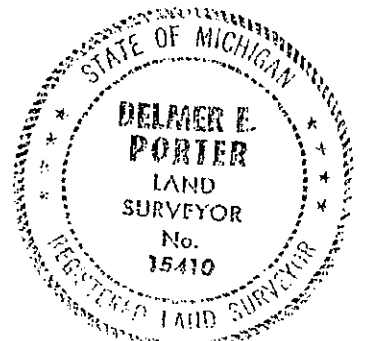

Signed by

Delmer E. Porter

Date

Dec 20, 1993Surveyor's Michigan License No. 15410

CORNER HISTORY RESEARCH SHEET

J-13

T34N,R2E ALLIS TOWNSHIP-NORTH PART,
PRESQUE ISLE COUNTY, MICHIGAN.

ACTIVITY	MONUMENT & ACCESSORIES	COMMENTS
----------	------------------------	----------

GLO Survey
July 3, 1855

Cedar 10" N25°E 10 Links
Cedar 10" N49°W 28 Links

Act 74 filing by:
Ronald R. Bischer,
#22428, July 13, 1982
Page 604,
Corner Recordation

Established corner 33' South
of North Fe, Line & on
extension of a very old
Fe. line to the North reported
to be the N-S 1/4 line Fence
1/2" Rod in Road
N46°W 89.50' 12" W. Pine
S08°E 36.79' 14" Spruce
N02°E 33.18' Fe. Cor.

Mortgage Report by:
Porter's Survey
May 4, 1989
Survey#175-89
File#34R2234-M

1/2" Rod
S08°E 36.79' 14" Spruce
N46°W 89.50' 12" N. Pine
N02°E 33.18' Fe. Cor.

Remonumentation
Sept. 13, 1993

Fd. 1/2" Rod in Road
N45°W 89.57' 18" W. Pine
S03°E 37.01' 18" Spruce
Left Same
N45°W 89.57' 18" W. Pine
N37°E 87.75' 18" Spruce
S03°E 37.01' 19" Spruce
S65°W 74.01' 6" Cedar

#5