

1996 PRESQUE ISLE COUNTY, STATE OF MICHIGAN REMONUMENTATION

LAND CORNER RECORDATION CERTIFICATE
Filing Requirement of Act 74, Mich. P.A. 1970

LIBER 319 PAGE 115

For corners in

Presque Isle
(County)

Located in:

Corner Code #

1. Public Land Survey

T 34N R 5E F-11
T R
T R
T R
T R
S T R
S T R
S T R
S T R

2. Property Controlling
in Section

3. Miscellaneous
Property in Sec.

PRESQUE ISLE COUNTY
RECORDED

96 JUL 12 AM 11:39

James M. Beck
REGISTER OF DEEDS

Register of Deeds Stamp & File Number

4. Lot No. _____, Recorded Plat _____
5. Private Claims _____

I, James A. Beck, in a field survey on Mar 11, 1996 do hereby state that under requirements of P.A. 74, Michigan P.A. of 1970, the corner points mentioned in lines 1 and 2 above were in conformance with regulations and rules therefore as required in the current manual of survey instructions of the United States Department of the Interior, Bureau of Land Management or by a decree of a Court of Law and /or that the corner points mentioned in lines 3, 4 and 5 above were in conformance with the rules of the Michigan Board of Land Surveyors or by a Decree of a Court of Law; established, re-established, monumented, recovered, found as expressed below:

NOTE: Not more than 2 corners, all in the same town and range, may be recorded on this certificate.

	A	B	C	D	E	F	G	H	I	J	K	L	M
1													
2		6		5		4		3		2		1	
3													
4		7		8		9		10		11		12	
5													
6		18		17		16		15		14		13	
7													
8		19		20		21		22		23		24	
9													
10		30		29		28		27		26		25	
11													
12		31		32		33		34		35		36	
13													

A. Description of original monument and accessories and/or subsequent restoration:
F-11

G.L.O. 1856
Alfred Millerd

" Set 1/4 Sec. Post "
Cedar 10 S38W 35
Cedar 12 N50E 19

Sep. 28 1978
P.A. 74 Recordation
by Delmer Porter
Reg. No. 15410

1/2" rod
Witnesses:
N 12°W 39.68' 3" Elm
N 07°E 31.52' Fe. Cor.
N 58°E 58.20' 7" Elm

D. Porter found cedar stake
and 1/2" rod

Ratified by Peer Group
in accordance with P.A. 345

Chairman *Delmer Porter*
Date 5/22/96

B. Description of corner evidence found and/or method applied in restoring or reestablishing corner:
F-11

1996 Remonumentation
by James A. Beck
P.S. 21559

Found 1/2" rod and
remnants of old cedar stake; set P.S. 21559 cap on 1/2" rod
witnesses:


N 12°W 39.68', P.S. 21559 tag in 8" Elm
N 07°E 31.52' P.S. 21559 tag in fence corner
N 58°E 58.20' P.S. 21559 tag in 7" Elm } old witnesses

C. Description of monument for corner and accessories established to perpetuate locating the position of the corner:
F-11

1996 Remonumentation
by James A. Beck
P.S. 21559

1/2" rod and
remnants of old cedar stake; set P.S. 21559 cap on 1/2" rod
witnesses:

N 12°W 39.68', P.S. 21559 tag in 8" Elm
N 07°E 31.52' P.S. 21559 tag in fence corner
N 58°E 58.20' P.S. 21559 tag in 7" Elm
N 22°E 52.47' P.S. 21559 tag in 4" Elm
S 63°W 54.52' P.S. 21559 tag in 3" Spruce
S 19°E 34.86' P.S. 21559 tag in 2" Spruce

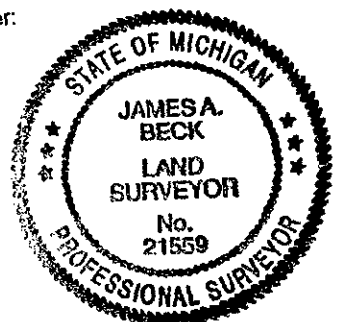

Signed by

James A. Beck

Date June 17, 1996

Surveyor's Michigan License No. _____

21559