

1997 PRESQUE ISLE COUNTY, STATE OF MICHIGAN REMONUMENTATION

PRESQUE ISLE COUNTY
RECORDEDLAND CORNER RECORDATION CERTIFICATE
Filing Requirement of Act 74, Mich. P.A. 1970

DEC 22 AM 9:56

For corners in

Presque Isle
(County)

Located in:

Corner Code #

1. Public Land Survey

T34NR 5E

J-13

T R

T R

T R

T R

2. Property Controlling
in Section

S

T R

S

T R

3. Miscellaneous
Property in Sec.

S

T R

S

T R

Janet M. Lamb
REGISTER OF DEEDS

Register of Deeds Stamp & File Number

4. Lot No. _____, Recorded Plat _____
5. Private Claims _____

I, Ronald Bischer, in a field survey on Oct 1, 1997 do hereby state that under requirements of P.A. 74, Michigan P.A. of 1970, the corner points mentioned in lines 1 and 2 above were in conformance with regulations and rules therefore as required in the current manual of survey instructions of the United States Department of the Interior, Bureau of Land Management or by a decree of a Court of Law and/or that the corner points mentioned in lines 3, 4 and 5 above were in conformance with the rules of the Michigan Board of Land Surveyors or by a Decree of a Court of Law; established, re-established, monumented, recovered, found as expressed below:

NOTE: Not more than 2 corners, all in the same town and range, may be recorded on this certificate.

	A	B	C	D	E	F	G	H	I	J	K	L	M
1													
2	6			5		4		3		2		1	
3													
4	7			8		9		10		11		12	
5													
6	18			17		16		15		14		13	
7													
8	19			20		21		22		23		24	
9													
10	30			29		28		27		26		25	
11													
12	31			32		33		34		35		36	
13													

A. Description of original monument and accessories and/or subsequent restoration:

J-13

GLO Notes

John Hodgson

1840 Original Survey

Set Post

Spruce 7" N31° E 9 lks

Spruce 10" N23° W 28 lks

1979 Delmer Porter #15410

Found ½" Rod

Set two witnesses

1979 Delmer Porter #15410

Replace ½" rod with Remon. Monument

B. Description of corner evidence found and/or method applied in restoring or reestablishing corner:

J-13


Found ½" Rod in Mon. Box

Set cap #22428 on ½" Rod

SURVEY &
REMONUMENTATION

JAN 14 1998

SECTION

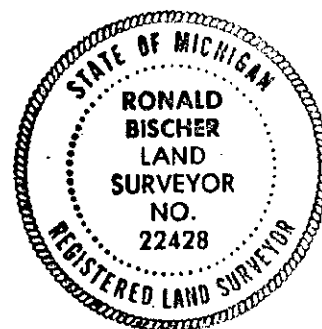

C. Description of monument for corner and accessories established to perpetuate locating the position of the corner:

J-13

½" Rod and cap #22428 in Mon. Box

S55° W 58.50' Power Pole

S30° E 60.25' 4" Cedar

N51° W 52.48' Power Pole

N31° E 68.71' 8" Cedar

Ratified by Peer Group
in accordance with P.A. 345Chairman Norman J. QuinnDate 10/30/97Signed by Ronald R. BischerDate Oct. 8, 1997Surveyor's Michigan License No. 22428