

97 DEC 23 AM 11:18

LIBER 325 PAGE 198

LAND CORNER RECORDATION CERTIFICATE
Filing Requirement of Act 74, Mich. P.A. 1970

For corners in

Presque Isle
(County)

Located in:

Corner Code #

1. Public Land Survey

T34N R 5E L-9
T R
T R
T R
S T R
S T R
S T R
S T R

2. Property Controlling
in Section

3. Miscellaneous
Property in Sec.

4. Lot No. , Recorded Plat
5. Private Claims

SURVEY &
REMONUMENTATION

JAN 14 1998

SECTION

Register of Deeds Stamp & File Number

I, Delmer E. Porter in a field survey on 3-27, 1997 do hereby state that under requirements of P.A. 74, Michigan P.A. of 1970, the corner points mentioned in lines 1 and 2 above were in conformance with regulations and rules therefore as required in the current manual of survey instructions of the United States Department of the Interior, Bureau of Land Management or by a decree of a Court of Law and/or that the corner points mentioned in lines 3, 4 and 5 above were in conformance with the rules of the Michigan Board of Land Surveyors or by a Decree of a Court of Law; established; re-established, monumented, recovered, found as expressed below:

NOTE: Not more than 2 corners, all in the same town and range, may be recorded on this certificate.

	A	B	C	D	E	F	G	H	I	J	K	L	M
1													
2	6			5			4			3		2	1
3													
4	7			8			9			10		11	12
5													
6	18			17			16			15		14	13
7													
8	19			20			21			22		23	24
9													
10	30			29			28			27		26	25
11													
12	31			32			33			34		35	36
13													

A. Description of original monument and accessories and/or subsequent restoration:

L-9
GLO Notes Intersect Beaver Pond
Alfred Millard NE & SW & Set Witness
July 8, 1856 Cor to Qr. Corner
Spruce 8" N82° E 66 Lk
W Pine 8" S77° E 68 Lk

D. Porter #15410
N. Quaine #33984
Act 74 Filing
July 12, 1989
L. 1 Pg. 763

Fd. Stake Point & 1/2"
Bar @ FE Brace E-W
Left 1/2" Rod & Cap
#15410
N80° E 1.35' 3" B. Ash
S08° E 17.44' 3" B. Ash
S77° W 12.25' 4" Maple

"Continued on Back"

B. Description of corner evidence found and/or method applied in restoring or reestablishing corner:


L-9
Fd. 1/2" Rod & Cap #15410
By Stake Point & Base of Fence Post
15' +/- North to E-W Drainage Ditch
N80° E 1.35' 4" B. Ash
S42° E 12.35' 3" B. Ash
S04° E 17.37' 6" B. Ash
S86° W 12.27' 6" Maple

Ratified by Peer Group
in accordance with P.A. 345

Chairman Norman J. Quaine
Date 12/04/97

C. Description of monument for corner and accessories established to perpetuate locating the position of the corner:

L-9
1/2" Rod & Cap #15410
By Stake Point & Base of Fence Post
15' +/- North to E-W Drainage Ditch
N80° E 1.35' 4" B. Ash
S42° E 12.35' 3" B. Ash
S04° E 17.37' 6" B. Ash
S86° W 12.27' 6" Maple

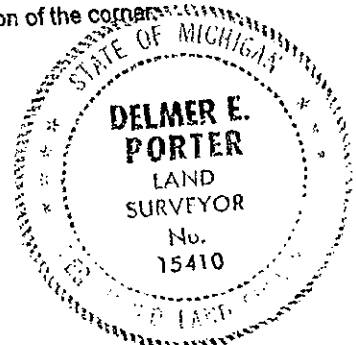

Signed by Delmer E. Porter
Surveyor's Michigan License No. 15410

Date 12/18/97

A Continued:

J. Beck, #21559	Fd. 1/2" Rod & Porter's Survey Cap
Act 74 Filing	N80° E 1.35' 3" B. Ash
Oct. 11, 1993	S08° E 17.44' 3" B. Ash
L. 307 Pg. 301	Left 1/2" Rod & Porter's Survey Cap
	N80° E 1.35' 3" B. Ash
	S08° E 17.44' 3" B. Ash
	S77° W 12.25' 4" Maple
	S40° E 12.23' 6" B. Ash

J. Beck, #21559	N80° E 1.35' 3" B. Ash
Act 132 Survey	S08° E 17.44' 3" B. Ash
Sept. 30, 1993	S77° W 12.25' 4" Maple
Rec. Jan. 13, 1994	S40° E 12.23' 6" B. Ash
L. 308 Pg. 320	No Mention Cor.