

LIBER 325 PAGE 200

LAND CORNER RECORDATION CERTIFICATE
Filing Requirement of Act 74, Mich. P.A. 1970

97 DEC 23 AM 11:19

For corners in

Presque Isle
(County)

Located In:

Corner Code #

1. Public Land Survey

T 34N R 5E

L-11

2. Property Controlling
in Section

S

T R

3. Miscellaneous
Property in Sec.

S

T R

4. Lot No. , Recorded Plat

5. Private Claims

I, Delmer E. Porter, in a field survey on 3-27, 19 97 do hereby state that under requirements of P.A. 74, Michigan P.A. of 1970, the corner points mentioned in lines 1 and 2 above were in conformance with regulations and rules therefore as required in the current manual of survey instructions of the United States Department of the Interior, Bureau of Land Management or by a decree of a Court of Law and/or that the corner points mentioned in lines 3, 4 and 5 above were in conformance with the rules of the Michigan Board of Land Surveyors or by a Decree of a Court of Law; established, re-established, monumented, recovered, found as expressed below:

NOTE: Not more than 2 corners, all in the same town and range, may be recorded on this certificate.

SURVEY &
REMONUMENTATION

JAN 14 1998

Register of Deeds Stamp & File Number

	A	B	C	D	E	F	G	H	I	J	K	L	M
1													
2	6		5		4		3		2		1		
3													
4	7		8		9		10		11		12		
5													
6	18		17		16		15		14		13		
7													
8	19		20		21		22		23		24		
9													
10	30		29		28		27		26		25		
11													
12	31		32		33		34		35		36		

A. Description of original monument and accessories and/or subsequent restoration:

L-11

GLO Notes

Set Qr. Sec. Post

Alfred Millard B. Ash 10" S2°W 17 Lk

July 8, 1856 B. Ash 8" N9°W 14 Lk

D. Porter #15410

N. Quaine #33984

Act 74 Filing

L. 1 Pg. 764

July 12, 1989

Set 1/2" Rod & Cap

#15410 by Single Prop.

N56°E 31.86' 8" Tw Elm

S45°E 70.28 8" Tw Elm

S55°E 39.70' South Edge

C.M.P.

P.I. County Remon.

"Continued on Back"

B. Description of corner evidence found and/or method applied in restoring or reestablishing corner:

L-11

Fd. 1/2" Rod

Put Cap #33984 On

55.5' East of C/L - C/L Rd. Int.

N56°E 31.98' 8" Tw. Elm

S43°E 70.04' 8" Tw. Elm

S55°E 39.70' S. Edge C.M.P.

N87°W 81.75' 6" Aspen

Ratified by Peer Group
in accordance with P.A. 345

Chairman

Date

12/04/97

C. Description of monument for corner and accessories established to perpetuate locating the position of the corner:

L-11

1/2" Rod & Cap #33984

55.5' East of C/L - C/L Rd. Int.


N56°E 31.98' 8" Tw. Elm

S43°E 70.04' 8" Tw. Elm

S55°E 39.70' S. Edge C.M.P.

N87°W 81.75' 6" Aspen

N84°E 80.06' 7" Aspen

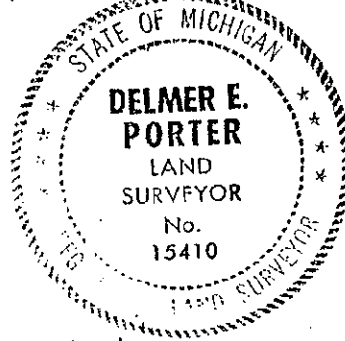

Signed by

Date

12/18/97

Surveyor's Michigan License No.

15410

A Continued:

J. Beck, #21559	Fd. 1/2" Rod & Porter's Survey Cap
Act 74 Filing	N56°E 31.86' 8" Tw. Elm
Oct. 11, 1993	S45°E 70.28' 8" Tw. Elm
L. 307 Pg. 301	S55°E 39.70' South Edge C.M.P.
	Left 1/2" Rod & Porter's Survey Cap
	N56°E 31.86' 8" Tw. Elm
	S45°E 70.28' 8" Tw. Elm
	S55°E 39.70' South Edge C.M.P.
	N89°W 81.77' 5" Poplar
J. Beck, #21559	N56°E 31.86' 8" Twin Elm
Act 132 Survey	S45°E 70.28' 8" Twin Elm
Sept. 30, 1993	S55°W 39.70' South Edge C.M.P.
Rec. Jan 13, 1994	N89°W 81.77' 5" Poplar
L. 308 Pg. 320	No Mention of Corner