

LAND CORNER RECORDATION CERTIFICATE
Filing Requirement of Act 74, Mich. P.A. 1970

87 DEC 23 AM 11:17

For corners in

Presque Isle
(County)

Located In:

Corner Code #

1. Public Land Survey

T	34	N	5	E	M-7
T		R			
T		R			
T		R			
T		R			
S		T		R	
S		T		R	
S		T		R	
S		T		R	

2. Property Controlling
in Section3. Miscellaneous
Property in Sec.4. Lot No. _____, Recorded Plat _____
5. Private Claims _____

I, Delmer E. Porter in a field survey on 3-31, 19 97 do hereby state that under requirements of P.A. 74, Michigan P.A. of 1970, the corner points mentioned in lines 1 and 2 above were in conformance with regulations and rules therefore as required in the current manual of survey instructions of the United States Department of the Interior, Bureau of Land Management or by a decree of a Court of Law and/or that the corner points mentioned in lines 3, 4 and 5 above were in conformance with the rules of the Michigan Board of Land Surveyors or by a Decree of a Court of Law; established, re-established, monumented, recovered, found as expressed below:

NOTE: Not more than 2 corners, all in the same town and range, may be recorded on this certificate.

A. Description of original monument and accessories and/or subsequent restoration:

M-7

GLO Notes

Alfred Millard
July 5, 1856

Set Post Cor of Sec 13&24
Hemlock 10" N78°W 10 Lk
Hemlock 9" S48°W 17 Lk
Old Cor Of Sec 13 & 24
6.50' S & 200 Lks W
Effaced

R. Bischer

#22428

Act 74 Filing

Dec 12, 1977

L. 1 Pg. 208

Fd. Spike

Left Spike

North 40.00' 1/2" Rod

South 40.00' 1/2" Rod

S36°E 55.62' P. Pole

"Continued on Back"

B. Description of corner evidence found and/or method applied in restoring or reestablishing corner:

M-7

Fd. 1/2" Rod & Cap #15410 in Mon Box
3.5' North of Road C/L
N07°E 39.92' 1/2" Rod & Cap #15410
S31°E 55.51' P. Pole

Ratified by Peer Group
in accordance with P.A. 345

Chairman Norman J. QuinnDate 12/18/97

C. Description of monument for corner and accessories established to perpetuate locating the position of the corner:

M-7

1/2" Rod & Cap #15410 in Mon Box
3.5' North of Road C/L
N07°E 39.92' 1/2" Rod & Cap #15410
S31°E 55.51' P. Pole
S13°E 68.42' E'ly Steel Gate Post
S11°W 100.07' 9" Aspen
S22°W 104.57' 6" Aspen

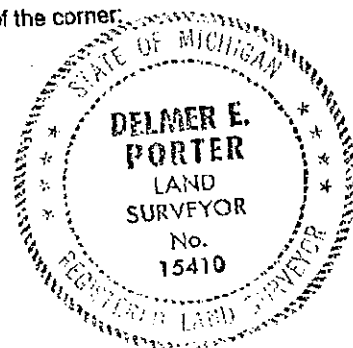
Signed by

Delmer E. Porter

Surveyor's Michigan License No.

15410

Date

12/18/97

A continued:

D. Porter, #15410	Cabin Spike
Act 132 Survey	North 40' 1/2" Rod
Nov. 7, 1977	South 40' 1/2" Rod
Rec. Dec. 27, 1977	S36° E 55.62' P. Pole
L. 220 Pg. 601	