

LAND CORNER RECORDATION CERTIFICATE  
Filing Requirement of Act 74, Mich. P.A. 1970

For corners in  
PRESQUE ISLE  
(County)

Located In:

Corner Code ##

1. Public Land Survey	T <u>35N</u> R <u>3E</u>	<u>J-3, K-3</u>
	T <u>    </u> R <u>    </u>	<u>    </u>
	T <u>    </u> R <u>    </u>	<u>    </u>
	T <u>    </u> R <u>    </u>	<u>    </u>
2. Property Controlling in Section	S <u>11</u> T <u>    </u> R <u>    </u>	<u>4, 5</u>
	S <u>    </u> T <u>    </u> R <u>    </u>	<u>    </u>
3. Miscellaneous Property in Sec.	S <u>    </u> T <u>    </u> R <u>    </u>	<u>    </u>
	S <u>    </u> T <u>    </u> R <u>    </u>	<u>    </u>

Register of Deeds Stamp & File Number

4. Lot No.         , Recorded Plat           
5. Private Claims         


I, CARL F. ROSER, in a field survey on JUNE 7,, 19 94,  
do hereby certify that under requirements of P.A. 74, Michigan P.A. of 1970, the corner points mentioned  
in lines 1 and 2 above were in conformance with regulations and rules therefore as required in the  
current manual of survey instructions of the United States Department of the Interior, Bureau of Land  
Management or by a decree of a Court of Law and/or that the corner points mentioned in lines 3, 4 and 5  
above were in conformance with the rules of the Michigan Board of Land Surveyors or by a Decree of a  
Court of Law; established, re-established, monumented, re-monumented, recovered, found as  
expressed below:

NOTE: Not more than 4 corners, all in the same town and range, may be recorded  
on this certificate.

A. Description of original monument and accessories and/or subsequent restoration:  
J-3 K-3 4 5

(NO EVIDENCE OF G.L.O. CORNER, B.T.'S, LINE TREES & TOPOGRAPHY,  
AS CALLED OUT IN THE G.L.O. LINE NOTES; UNLESS NOTED IN ITEM "B"  
BELOW.)

	A	B	C	D	E	F	G	H	I	J	K	L	M
2	6	5	4	3	2	1							
3													
4	7	8	9	10	11	12							
5													
6	18	17	16	15	14	13							
7													
8	19	20	21	22	23	24							
9													
10	30	29	28	27	26	25							
11													
12	31	32	33	34	35	36							
13													

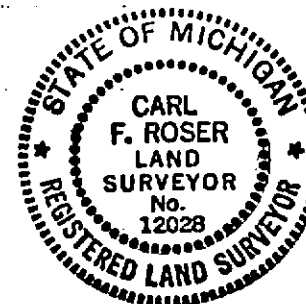

B. Description of corner evidence found and/or method applied in restoring or reestablishing corner:

<u>J-3</u> FD 1/2" ROD FOR N 1/4 OF SEC 11, BELIEVED TO HAVE BEEN SET BY P.S. RON BISCHER.	<u>K-3</u> FD AND ACCEPTED 1/2" ROD W/P.S. #22428 CAP, RON BISCHER, FOR NE COR OF SEC 11.	<u>4</u> ESTAB'D NW COR OF SE 1/4 OF NW 1/4 OF SEC 11 (CENTER OF NW 1/4) PER STD BLM INSTRUCTIONS FOR SEC SUBN'S.	<u>5</u> ESTAB'D NE COR OF SE 1/4 OF NW 1/4 OF SEC 11 PER STD BLM INSTRUCTIONS FOR SEC SUBN'S. COR FALLS IN OPEN FARMED FIELD.
---	--	---	---

C. Description of monument for corner and accessories established to perpetuate locating the position of the corner:

<u>J-3</u> FD 1/2" IR ROD. PLACED CEDAR POST W/LOC TAG. (LARGE NAILS W/BASS TAGS ON WITS.) 3" SPRUCE S15°W 12.09' STEEL WELL CASING N64°E 5.12' C/L N-S TRL RD EAST 13.3' FENCE POST N28°E 11.87' 1/2" IR ROD, N1/4 COR, 15 BETW E-W B-WIRE FENCE & LARGE STONE.	<u>K-3</u> FD 1/2" IR ROD W/CAP AND SET CED POST W/LOC TAG. LG NAILS/BASS TAGS ON WITS. #18" J PINE N75°E 13.32' 12" J PINE N05°W 13.08' 10" J PINE S28°W 3.06' # 8" J PINE S26°E 13.37' OLD WIT, POSSIBLY BISCHER.	<u>4</u> SET 5/8" X 34" REROD W/CAP & CED POST W/LOC TAG. LG NAILS W/BASS TAGS ON WITS. 14" CEDAR S26°W 22.74' 12" TAMARACK N36°W 14.99' 16" CEDAR N19°W 10.63' 6" BALSAM S26°E 9.53'	<u>5</u> SET 5/8" X 34" REROD W/CAP & 2 CED POSTS. 9" MAPLE S55°E 53.49' 5" W PINE S26°E 41.03' 6" POPLAR S49°W 32.14' E-W B-WIRE FENCE SOUTH 15' N-S B-WIRE FENCE EAST 118'
--	---	--	---

Signed by Carl F. Roser Date 6-08-95  
Surveyor's Michigan License No. 12028