

FEB 12 2001

SECTION

LIBER 340 PAGE 336

YEAR 2000 PRESQUE ISLE COUNTY, STATE OF MICHIGAN REMONUMENTATION

LAND CORNER RECORDATION CERTIFICATE
Filing Requirement of Act 74, Mich. P.A. 1970For corners in
PRESQUE ISLE
(County)

Located in:

Corner Code #

1. Public Land Survey

T 35N R 2E

16

T 35N R 2E

17

T R

T R

2. Property Controlling
in Section

S T R

S T R

3. Miscellaneous
Property in Sec.

S T R

S T R

4. Lot No. , Recorded Plat

5. Private Claims

PRESQUE ISLE COUNTY
RECORDED

2000 DEC 11 AM 9:46

James M. Samt
REGISTER OF DEEDS

Register of Deeds Stamp & File Number

I, James A. Beck, in a field survey on Sep 28 & Sep 29, 2000

do hereby certify that under requirements of P.A. 74, Michigan P.A. of 1970, the corner points mentioned in lines 1 and 2 above were in conformance with regulations and rules therefore as required in the current manual of survey instructions of the United States Department of the Interior, Bureau of Land Management or by a decree of a Court of Law and/or that the corner points mentioned in lines 3, 4 and 5 above were in conformance with the rules of the Michigan Board of Land Surveyors or by a Decree of a Court of Law; established, re-established, monumented, re-monumented, recovered, found as expressed below.

NOTE: Not more than 4 corners, all in the same town and range, may be recorded on this certificate.

A. Description of original monument and accessories and/or subsequent restoration:

16 November 11, 1997 P.A. 74 (Land Corner Recordation
Certificate) by Ronald Blecher P.S. 22428

"Set 1/2" rod from O.B.T.'s"

S25E 7.59' foot blaze on White Pine stump O.B.T.

N30W 16.5' Rotten Spruce Stump O.B.T.

N84W 47.90' 20' Norway

S23W 8.05' 22' White Pine

N44W 33.23' 22' Norway

S59W 62.87' 24' White Pine

17 July 5, 1973 P.A. 74 Recordation by Delmer Porter P.S. 15410

6" Balsam N55°W 62.87'

10° W. Pine S28°W 43.63'

18° N. Pine S64° 121.78.

Mar. 17, 1975 P.A. 132 by Delmer Porter Recorded L208, P646
set 1/2" rod from Delometers witnesses

N55°W 62.87' 6" Balsam

S64°E 121.78' 18° N. Pine

S28°W 43.63' 10° N. Pine

B. Description of corner evidence found and/or method applied in restoring or reestablishing corner:

16 found 1/2" iron and 22428 cap remnants of above original
bearing tree stumps visible

N84°W 47.90' 20' Norway Pine

S23°W 8.05' 22' White Pine

N44°W 33.23' 22' Norway Pine

S59°W 62.87' 24' White Pine

17 found 1/2" iron rod in monument box & 2 old witnesses:

S64°E 121.78' 20' Norway Pine (old tag grown over)

S28°W 43.63' 10' Norway Pine

Ratified by Peer Group
in accordance with P.A. 345Chairman *William J. Quinn*Date 12-11-00

C. Description of monument for corner and accessories established to perpetuate locating the position of the corner:

16 1/2" iron and 22428 cap
remnants of above original bearing tree stumps visible
Witnesses:

N84°W 47.90' P.S. 22428 tag in 20' Norway Pine

S23°W 8.05' P.S. 22428 tag in 22' White Pine

N44°W 33.23' P.S. 22428 tag in 22' Norway Pine

S59°W 62.87' P.S. 22428 tag in 24' White Pine

N20°W 17.91' P.S. 21559 tag in 5' Maple

N68°E 22.47' P.S. 21559 tag in 5' Maple

17 1/2" iron rod & P.S. 21559 cap in monument box
Witnesses:

S64°E 121.78' P.S. 21559 tag in 20' Norway Pine

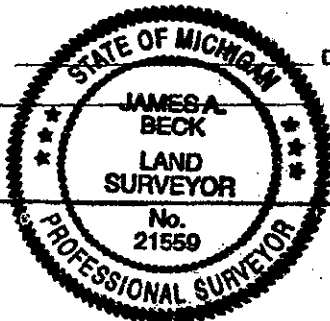
S28°W 43.63' 10' P.S. 21559 tag in 10' Norway Pine

N27°W 45.60' P.S. 21559 tag in 14' White Pine

N56°E 61.85' P.S. 21559 tag in 6' Oak

Signed by *James A. Beck* P.S. 21559

Surveyor's Michigan License No.

Date Nov. 7, 2000FORM APPROVED BY MICHIGAN STATE BOARD OF LAND SURVEYORS, JAN. 25, 1971
REVISED MAY 14, 1975
NEWBOLD JAN., 1983