

LAND CORNER RECORDATION CERTIFICATE
Filing Requirement of Act 74, Mich. PA 1970

For Corners In:
Presque Isle
(County)
Located In
Corner Code #


1. Public Land Survey
2. Property Controlling in Section
3. Miscellaneous Property in Section

4. Lot No:
Recorded Plat:
5. Private Claims:

I, Carl T. Kiiskila, in a field survey on August 5, 2009 do hereby state that under requirements of PA 74, Michigan PA of 1970, the corner points mentioned in lines 1 and 2 above were in conformance with regulations and rules therefore as required in the current manual of survey instructions of the United States Department of the Interior, Bureau of Land Management or by a decree of a Court of Law and/or that the corner points mentioned in lines 3, 4 and 5 above were in conformance with the rules of the Michigan Board of Land Surveyors or by a Decree of a Court of Law; established, re-established, monumented, recovered, found as expressed below:

NOTE: Not more than 2 corners, all in the same town and range, may be recorded on this certificate.

Register of Deeds Stamp & File Number

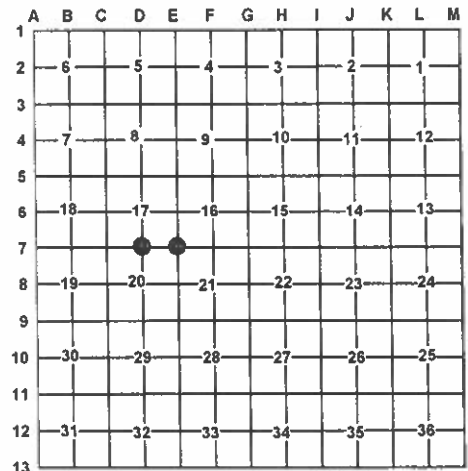

A. Description of original monument and accessories and/or subsequent restoration:

D-7 1/4 Corner comm. to sec.'s 17 & 20, T36N,R2E

E-7 Sec. Corner comm. to sec.'s 16,17,20,21, T36N,R2E

1856 - GLO - George H. Cannon - Set quarter section post.
Y.Pine 18" N54°W 122 links
Sp.Pine 7" S7°E 26 links
1926 - "1926 Survey" in GLO book - pg. 62 - C.M. Cade - Oak stake -
Distance 39 from corners East and West. 6" J.Pine N82°E 33 links; 4" J.Pine N17°E 39.5 links; 6" J.Pine N11°E 30 links; 8" J.Pine N3°W 38 links; No trace of original corner.
1994 - L.C.R.C - L.311, p.125 - Norman J. Quaine, P.S.#33984 - Found no evidence indicating corner's position. Set 1/2" rod and Cap#15410 by single proportion.
N56°E 15.41' 9" R.Pine
S31°E 36.18' 11" Oak
S51°W 36.13' 10" R.Pine
N51°W 35.72' 11" Twin Oak

1856 - GLO - George H. Cannon - Set post corner of sec.'s 16,17,20,21.
Y.Pine 22" S31°E 105 links
Y.Pine 16" N42°W 37 links
1926 - "1926 Survey" in GLO book - pg. 54 - C.M. Cade - Found both Government BT's with blazes. A 4"x4" hewed oak stake was found at the point.
1994 - L.C.R.C - L.311, p.251 - James A. Beck, P.S.#21559 - Found Presque Isle Co. remonumentation monument. Corner is in C/L trail roads intersection.
N57°E 18.53' 13" Oak
S44°E 37.60' 8" R.Pine
S25°E 52.76' 7" R.Pine
S62°W 48.46' 11" Oak

B. Description of corner evidence found and/or method applies in restoring or re-establishing corner:

D-7 1/4 Corner comm. to sec.'s 17 & 20, T36N,R2E

E-7 Sec. Corner comm. to sec.'s 16,17,20,21, T36N,R2E

Found 1/2"x24" CIR #15410, per L.C.R.C, L.311, p.125, 6" below grade in E-W 2-track and N-S 2-track 12' West. Accepted found 1/2" x 24" CIR as a careful and faithful reestablishment of the position of the original corner. Replaced found CIR with a standard DNR monument, placed monument 1' below grade. Found no other evidence to dispute location for corner.

Found Presque Isle Co. monument, a stamped 3" dia. brass cap on a concrete monument 2" below grade in intersection of trail roads N-S & E-W. Found 22-24" Yellow Pine stump that fits bearing and distance to GLO. Accepted found Presque Isle Co. monument as a careful and faithful perpetuation of the position of the original corner. Found no other evidence to dispute the location for the corner.

C. Description of monument for corner and accessories established to perpetuate locating the position of the corner:

D-7 1/4 Corner comm. to sec.'s 17 & 20, T36N,R2E

E-7 Sec. Corner comm. to sec.'s 16,17,20,21, T36N,R2E

Set stamped 4" Dia. Alum. DNR cap on 1"x36" galv. Pipe

Stamped 3" dia. brass cap on concrete monument.

Wit: \*N46°E 14.99' to set N&T at old N&T on SE side 12" R.Pine
\*S24°E 36.15' to set N&T at old N&T on S side 15" R.Oak
\*S42°W 36.12' to set N&T at old N&T on W side 13" R.Pine
\*N45°W 35.23' to set N&T at old N&T on NE side 13" Twin R.Oak

Wit: \*N49°E 18.61' to set N&T at old N&T on SE side 18" Oak
\*S36°E 37.58' to set N&T at old N&T on SW side 11" R.Pine 'XBT'
\*S17°E 52.79' to set N&T at old N&T on NE side 11" R.Pine 'XBT'
\*S56°W 48.43' to set N&T at old N&T on SE side 11" R.Oak
S22°E 69.3' to face of remains of 22-24" Y.Pine stump
\* Previous recorded witness.

\* Previous recorded witness.

'XBT' Scribed 'XBT' on bottom blaze.

Surveyor's Michigan License No.:

33981

