

2647

1995 STATE OF MICHIGAN REMONUMENTATION

JAN 17 1996

LAND CORNER RECORDATION CERTIFICATE
Filing Requirement of Act 74, Mich. P.A. 1970

95 DEC 14 AM 10:28

For corners in

Presque Isle

(County)

Located In:

Corner Code #

1. Public Land Survey

36N 2E

D3

2. Property Controlling
in Section

S T R

3. Miscellaneous

S T R

Property in Sec.

S T R

4. Lot No. , Recorded Plat

5. Private Claims

James M. Schmitt
REGISTER OF DEEDS

LIBER 316 PAGE 931

Register of Deeds Stamp & File Number

I, James A. Beck in a field survey on July 13, 1995, do hereby certify that under requirements of P.A. 74, Michigan P.A. of 1970, the corner points mentioned in lines 1 and 2 above were in conformance with regulations and rules therefore as required in the current manual of survey instructions of the United States Department of the Interior, Bureau of Land Management or by a decree of a Court of Law and/or that the corner points mentioned in lines 3, 4 and 5 above were in conformance with the rules of the Michigan Board of Land Surveyors or by a Decree of a Court of Law; established, re-established, monumented, re-monumented, recovered, found as expressed below:

NOTE: Not more than 4 corners, all in the same town and range, may be recorded on this certificate.

A. Description of original monument and accessories and/or subsequent restoration:

D3

1856:

Government Resurvey

* by Geo. H. Cannon

Set post and referenced:

Birch 12" N60°E 33 Links

Birch 14" S75°W 75 Links

Nov. 29, 1978:

Corner Recorded by

Delmer E. Porter,

P.S. 15410.

Found 1 1/2" pipe at intersection of two sand trails. Set conc. monument and brass cap. Referenced:

N42°W 19.45 3" Maple

S44°W 22.12 4" Maple

S26°E 48.99 5" Maple

B. Description of corner evidence found and/or method applied in restoring or reestablishing corner:

D3

Found Presque Isle County (local)

remonumentation monument

(cement with brass cap) at intersection

of 2 rut fire lanes East-West and South

found all witness trees from recordation

by Delmer Porter from Nov. 29, 1978

set new witness tags P.S. 21559 as old tags grown over

Ratified by Peer Group
in accordance with P.A. 345

Chairman Delmer E. Porter

Date 11/21/95

C. Description of monument for corner and accessories established to perpetuate locating the position of the corner:

D3

July 13, 1995

1995 Remonumentation

by James A. Beck

P.S. 21559

Cement monument with brass cap


Witnesses:

N 42°W 19.25', 4" stem of twin Maple

S 44°W 22.08', 7" Maple

S 26°E 49.00', 9" Maple

N34°E 16.86', 3" Beech (new witness)

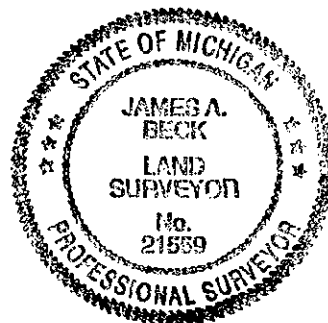

Signed by

James A. Beck
21559

Date

11-28-1995

Surveyor's Michigan License No.