

LAND CORNER RECORDATION CERTIFICATE  
Filing Requirement of Act 74, Mich. P.A. 1970

94 SEP 12 AM 10:41

For corners in

<u>Presque Isle</u> (County)	Located In:	Corner Code #
1. Public Land Survey	T <u>36N</u> R <u>2E</u>	<u>E-7</u>
	T _____ R _____	_____
	T _____ R _____	_____
	T _____ R _____	_____
2. Property Controlling in Section	S _____ T _____ R _____	_____
	S _____ T _____ R _____	_____
3. Miscellaneous Property in Sec.	S _____ T _____ R _____	_____
	S _____ T _____ R _____	_____

*Just M. Lamb*  
REGISTER OF DEEDS

LIBER 311 PAGE 251

Register of Deeds Stamp & File Number

4. Lot No. \_\_\_\_\_, Recorded Plat \_\_\_\_\_  
5. Private Claims \_\_\_\_\_

I, James A. Beck, in a field survey on May 20, 19 94,  
do hereby certify that under requirements of P.A. 74, Michigan P.A. of 1970, the corner points mentioned  
in lines 1 and 2 above were in conformance with regulations and rules therefore as required in the  
current manual of survey instructions of the United States Department of the Interior, Bureau of Land  
Management or by a decree of a Court of Law and/or that the corner points mentioned in lines 3, 4 and 5  
above were in conformance with the rules of the Michigan Board of Land Surveyors or by a Decree of a  
Court of Law; established, re-established, monumented, re-monumented, recovered, found as  
expressed below:

NOTE: Not more than 4 corners, all in the same town and range, may be recorded  
on this certificate.

A	B	C	D	E	F	G	H	I	J	K	L	M
2	6		5		4		3		2		1	
3												
4	7		8		9		10		11		12	
5												
6	16		17		16		15		14		13	
7												
8	19		20		21		22		23		24	
9												
10	30		29		28		27		26		25	
11												
12	31		32		33		34		35		36	
13												

- A. Description of original monument and accessories and/or subsequent restoration:

E-7  
1856: In Government Resurvey set post and referenced:  
Y Pine 22" S31°E 105 Links  
Y Pine 16" N42°W 37 Links

- B. Description of corner evidence found and/or method applied in restoring or reestablishing corner:

E-7  
1994: Found "Presque Isle Remonumentation" monument.


Ratified by Peer Group  
in accordance with P.A. 345

Chairman *Richard E. Porter*  
Date August 29, 1994

- C. Description of monument for corner and accessories established to perpetuate locating the position of the corner:

E-7  
1994: "Presque Isle Remonumentation" monument at centerline of  
trail roads intersection.  
Witnesses:  
N57°E 18.53' 13" Oak\*  
S44°E 37.60' 8" Red Pine\*  
S25°E 52.76' 7" Red Pine\*  
S62°W 48.48' 11" Oak\*

\* = Set tag 21559

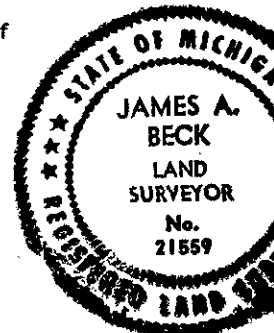

Signed by *James A. Beck*  
Surveyor's Michigan License No. 21559

Date August 25, 1994