

2240
1995 PRESQUE ISLE COUNTY, STATE OF MICHIGAN REMONUMENTATION
JAN 17 1996

COMMISSION
LAND CORNER RECORDATION CERTIFICATE
Filing Requirement of Act 74, Mich. P.A. 1970

For corners in
PRESQUE ISLE
(County)

Located In:

Corner Code #

PRESQUE ISLE COUNTY
REGISTERED

95 OCT 20 PM 4:36

Janet M. Lamb
REGISTER OF DEEDS

LIBER 316 PAGE 323
Register of Deeds Stamp & File Number

1. Public Land Survey T 36N R 2E M-5
T _____ R _____
T _____ R _____
T _____ R _____
2. Property Controlling S _____ T _____ R _____
in Section S _____ T _____ R _____
3. Miscellaneous S _____ T _____ R _____
Property in Section S _____ T _____ R _____
4. Lot No. _____, Recorded Plat _____
5. Private Claims _____

I, Ronald Bischer, in a field survey on July 27, 19 95,
do hereby certify that under requirements of P.A. 74, Michigan P.A. of 1970, the corner points mentioned
in lines 1 and 2 above were in conformance with regulations and rules therefore as required in the current
manual of survey instructions of the United States Department of the Interior, Bureau of Land
Management or by a decree of a Court of Law and/or that the corner points mentioned in lines 3, 4 and
5 above were in conformance with the rules of the Michigan Board of Professional Surveyors or by a
Decree of a Court of Law; established, re-established, monumented, re-monumented, recovered, found
as expressed below:

NOTE: Not more than 4 corners, all in the same town and range, may be recorded
on this certificate.

A. Description of original monument and accessories and/or subsequent restoration:

1856 Resurvey - GLO Notes

Geo. H. Cannon

Set Wood Post

Cedar 9" N75°W 15½ lks

Cedar 10" S50°W 29 lks

01-27-94 Ronald R. Bischer - #22428

Found ½" Rod

S45°W 18.04' 8" Cedar

N45°W 21.90' 5" Cedar

N08°E 9.80' 4" Cedar

B. Description of corner evidence found and/or method applied in restoring or reestablishing corner:


Found ½" Rod & Cap #22428 by very old 4"x4" cedar post.

N58°W 21.90' 6" Cedar

S54°W 18.04' 9" Cedar

N17°E 9.80' 4" Cedar

S50°W 19.20' OBT Stump - it was cut off above chest blaze

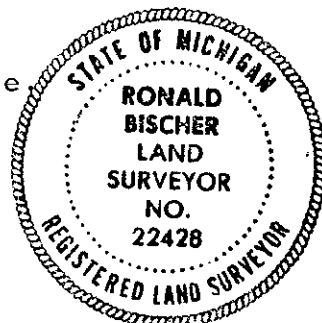

C. Description of monument for corner and accessories established to perpetuate locating the position of the corner:

½" Rod and Cap #22428

N58°W 21.90' 6" Cedar

S54°W 18.04' 9" Cedar

N17°E 9.80' 4" Cedar

S46°E 17.49' 5" Cedar

Nails with witness tag #22428 used.

Ratified by Peer Group

in accordance with P.A. 345

Chairman *Alvin E. Porter*

Date 9/20/95

Signed by Ronald R. Bischer

Date Oct. 3, 1995

Surveyor's Michigan License No. 22428