

LAND CORNER RECORDATION CERTIFICATE  
Filing Requirement of Act 74, Mich P.A. 1970

STATE OF MICHIGAN  
ROSCOMMON COUNTY  
RECORDED

For corners in  
Roscommon County

9 DEC 1999 2:33:00 PM

ROBERT W. SMITH  
REGISTER OF DEEDS

Located in: Corner Code #  
1. Public Land Survey T21N R1W C-11  
T R  
T R  
T R

I, Larry L. Cavanagh, in a field survey November, 1999, do hereby certify that under requirements of P.A. 74, Michigan P.A. of 1970, the corner points mentioned in line 1 above was in conformance with regulations and rules therefore as required in the current manual of survey instructions of the United States Department of the Interior, Bureau of Land Management or by a decree of a Court of Law; established, re-established, monumented, recovered, found as expressed below:

FILE IN LIBER 3 OF LAND CORNERS  
Register of Deeds Stamp & File Number

A. Description of original monument and accessories and/or subsequent restoration:

WILLIAM BURT 1850  
SET POST  
TAMARACK 8" N72°W 76 LKS  
TAMARACK 4" N29°E 1.31 CHAINS

LARRY L. CAVANAGH, 1975  
L311, P38, CERTIFICATE OF SURVEY  
NO MON MENTIONED  
SPIKE IN P. POLE N47°W 54.12'  
2" RED OAK N50°E 95.45'  
41' EAST OF FENCE (NORTH)  
1/2" BAR NORTH 33.0'

LARRY L. CAVANAGH, RLS 1975  
SECTION SUB-DIVISION SURVEY  
SET 1/2" X 18" STEEL BAR  
SPIKE IN P. POLE N47°W 54.12'  
2" R. OAK N50°E 95.45'  
REFERENCE BAR 33.0' NORTH

	A	B	C	D	E	F	G	H	I	J	K	L	M
2	6	5	4	3	2	1							
3													
4	7	8	9	10	11	12							
5													
6	18	17	16	15	14	13							
7													
8	19	20	21	22	23	24							
9													
10	30	29	28	27	26	25							
11													
12	31	32	33	34	35	36							
13													

B. Description of corner evidence found and/or method applied in restoring or reestablishing corner:

FOUND 1/2" X 18" BAR IN CENTERLINE OF BLACKTOP ROAD  
FOUND P. POLE AND 1/2" BAR FROM 1975 SURVEY

THE BEST AVAILABLE EVIDENCE OF THE POSITION OF THE ORIGINAL CORNER.

C. Description of monument for corner and accessories established to perpetuate locating the position of the corner:

SET STANDARD ROSCOMMON COUNTY MONUMENT IN PAV'T BOX STAMPED 17614  
WT: NAIL & TAG IN POWER POLE N47°W 54.04'  
1/2" CAPPED BAR NORTH 33.06'  
1/2" CAPPED BAR SOUTH 33.03' (LEDY, NOW DECEASED)  
NAIL & TAG IN 11" RED OAK N53°E 107.95'  
NAIL & TAG IN 5" ELM S30°E 38.67'  
CARSONITE POST SOUTH 25.15'


ROSCOMMON COUNTY  
PEER GROUP APPROVAL  
DATE NOV 30, 1999

*Marvin E. Myers*  
Marvin E. Myers, P.S.  
County Surveyor

Signed by *Larry L. Cavanagh*  
Surveyor's Michigan License NO. 17614

Date November 29, 1999

FORM APPROVED BY MICHIGAN STATE BOARD OF LAND SURVEYORS, JAN 28, 1971  
REVISED MAY 14, 1975  
REVISED JAN., 1983

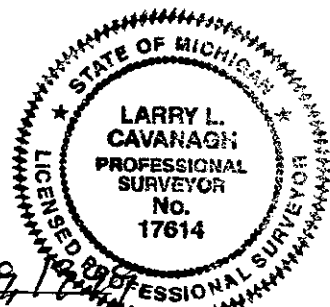

LIBER 3 PAGE 627

SURVEY &  
RE

OAK 1 2000

SECTION