

SURVEY REMONUMENTATION

ROSCOMMON COUNTY
PEER GROUP APPROVAL
DATE 11-10-94

APR 24 1995

LAND CORNER RECORDATION CERTIFICATE
Filing Requirement of Act 74, Mich. P.A. 1970

STATE OF MICHIGAN
ROSCOMMON COUNTY
RECORDED

For corners in

Roscommon
(County)

Located In:

Corner Code #

22 NOV 94 11:10 A.M.

ROBERT W. SMITH
REGISTER OF DEEDS

- | | | |
|------------------------------------|---|--------------|
| 1. Public Land Survey | T <u>23N</u> R <u>3W</u> | <u>F - 8</u> |
| | T <u> </u> R <u> </u> | <u> </u> |
| | T <u> </u> R <u> </u> | <u> </u> |
| | T <u> </u> R <u> </u> | <u> </u> |
| 2. Property Controlling in Section | S <u> </u> T <u> </u> R <u> </u> | <u> </u> |
| | S <u> </u> T <u> </u> R <u> </u> | <u> </u> |
| 3. Miscellaneous | S <u> </u> T <u> </u> R <u> </u> | <u> </u> |
| Property in Sec. | S <u> </u> T <u> </u> R <u> </u> | <u> </u> |

Register of Deeds Stamp & File Number

4. Lot No. , Recorded Plat
5. Private Claims

	A	B	C	D	E	F	G	H	I	J	K	L	M
2	6	5	4	3	2	1							
3													
4	7	8	9	10	11	12							
5													
6	18	17	16	15	14	13							
7													
8	19	20	21	22	23	24							
9													
10	30	29	28	27	26	25							
11													
12	31	32	33	34	35	36							
13													

Marvin E. Myers in a field survey on October 13, 19 94
do hereby certify that under requirements of P.A. 74, Michigan P.A. of 1970, the corner points mentioned in lines 1 and 2 above were in conformance with regulations and rules therefore as required in the current manual of survey instructions of the United States Department of the Interior, Bureau of Land Management or by a decree of a Court of Law and/or that the corner points mentioned in lines 3, 4 and 5 above were in conformance with the rules of the Michigan Board of Land Surveyors or by a Decree of a Court of Law; established, re-established, monumented, re-monumented, recovered, found as expressed below:

NOTE: Not more than 4 corners, all in the same town and range, may be recorded on this certificate.

4. Description of original monument and accessories and/or subsequent restoration:

Ostling 6-53
Mon-Fd. $\frac{1}{2}$ " Bar in C County Rd.
WIT: $\frac{1}{2}$ "x24" Bar & Squared Post West 33.00'
Larry Cavanagh 10-19-77 L.338, pg.565
Mon-Fd. $\frac{1}{2}$ " Steel Bar
WIT: 3" Oak S50°W 45.85'
18" Maple N45°W 54.85'
3" Maple S55°E 43.80'
 $\frac{1}{2}$ " Bar West 33.00'


3. Description of corner evidence found and/or method applied in restoring or reestablishing corner:

Found monument 5/8" x 15" Bar over $\frac{1}{2}$ " x 32" Bar in monument box in centerline Markey Road (County Road 100)
Found the following accessories:
Blaze in SE face 5' Maple Clump N36°W 54.81'
Blaze in NE face 8" R.Oak S61°W 45.13'
Blaze in NW face 5" Maple S53°E 43.57'

Accepted as the best available evidence of the position of the original corner.

2. Description of monument for corner and accessories established to perpetuate locating the position of the corner:

Mon-Set Standard Roscommon County Monument stamped "T23N R3W F-8 31600" in mon. box in centerline Markey Rd. (County Road 100)
WIT: Set Wit. Tag & Nail NE side 5" Maple Clump N36°W 55.32'
Set Wit. Tag & Nail SE side 8" R.Oak S61°W 45.48'
Set Wit. Tag & Nail NW side 14' R.Oak N59°E 63.35'
Set Wit. Tag & Nail SW side 5" Maple S53°E 43.89'
Set Carsonite Post N86°W 33.1'
N00°03'25"E 2638.09' to F-7
S00°02'36"W 2643.23' to F-9
S89°17'04"E 2654.11' to G-8
N89°15'37"W 2652.63' to E-8

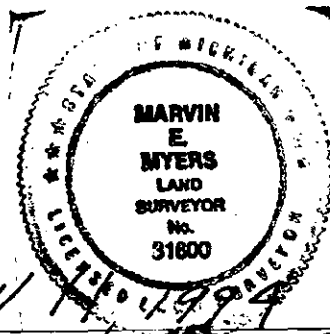

Signed by

Marvin E. Myers

Date

NOV 14 1994

Surveyor's Michigan License No. 31600

FORM APPROVED BY MICHIGAN STATE BOARD OF LAND SURVEYORS, JAN. 28, 1971
REVISED MAY 14, 1975
REVISED JAN., 1983

LIBER 3 Page 181