

8597

ROSCOMMON COUNTY
PEER GROUP APPROVAL

SURVEY &
REMONUMENTATION

DATE 10-20-94

APP 241095
LAND CORNER RECORDATION CERTIFICATE
Filing Requirement of Act 74, Mich. P.A. 1970
COMMISSION

STATE OF MICHIGAN
ROSCOMMON COUNTY
RECORDED

For corners in

Roscommon
(County)

Located In:

Corner Code #

1. Public Land Survey	T	T23N	R	3W	G - 9
	T		R		
	T		R		
	T		R		
2. Property Controlling in Section	S		T	R	
	S		T	R	
3. Miscellaneous Property in Sec.	S		T	R	
	S		T	R	

22 NOV 94 11:07 A.M.

ROBERT W. SMITH
REGISTER OF DEEDS

Register of Deeds Stamp & File Number

4. Lot No. _____, Recorded Plat _____
5. Private Claims _____

I, Marvin E. Myers, in a field survey on October 17, 1994, do hereby certify that under requirements of P.A. 74, Michigan P.A. of 1970, the corner points mentioned in lines 1 and 2 above were in conformance with regulations and rules therefore as required in the current manual of survey instructions of the United States Department of the Interior, Bureau of Land Management or by a decree of a Court of Law and/or that the corner points mentioned in lines 3, 4 and 5 above were in conformance with the rules of the Michigan Board of Land Surveyors or by a Decree of a Court of Law; established, re-established, monumented, re-monumented, recovered, found as expressed below:

NOTE: Not more than 4 corners, all in the same town and range, may be recorded on this certificate.

A. Description of original monument and accessories and/or subsequent restoration:

GLO-Artemas Curtis 1852	Henning L.265, pg. 444 6-73
Mon-Set Post	Mon-3/4" Iron Bar & Post
WIT: 6" B.Ash N85°W 13 lks.	as marked by G.F. DeLamater 1925
10" B.Ash S60°W 43 lks.	WIT: None Given


Henning 8-44
Mon-Fd. 3/4" Bar as set
by some previous survey
by DeLamater
WIT: None Given

B. Description of corner evidence found and/or method applied in restoring or reestablishing corner:

Found monument 3/4" x 30" Bar accepted as the best available evidence of the position of the original corner.

C. Description of monument for corner and accessories established to perpetuate locating the position of the corner:

Mon-Set Standard Roscommon County Monument stamped "T23N R3W G-9 31600"
WIT: Set Wit. Tag & Nail SE side 17" Maple N70°E 9.82'
Set Wit. Tag & Nail SW side 12" Maple N18°W 15.13'
Set Wit. Tag & Nail SW side 9" Maple N62°W 15.77'
Set Wit. Tag & Nail W. side 3" W.Birch S10°E 33.25'
Set Carsonite Post South 4.30'
S00°30'14"W 2631.84 to G-10

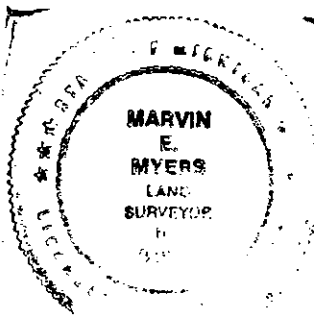

Signed by

Marvin E. Myers

Date

Nov 9, 1994Surveyor's Michigan License No. 31600

FORM APPROVED BY MICHIGAN STATE BOARD OF LAND SURVEYORS, JAN. 28, 1971
REVISED MAY 14, 1975
REVISED JAN., 1983

LIBER 3 PAGE 168