

8373

SURVEY &
REMONUMENTATION

ROSCOMMON COUNTY REMONUMENTATION

APR 24 1995

LAND CORNER RECORDATION CERTIFICATE

Filing Requirement of Act 74, Mich. P.A. 1970

STATE OF MICHIGAN
ROSCOMMON COUNTY
RECORDEDFor corners in
Roscommon

COMMISSION

(County)

Located In:

Corner Code ##

15 NOV 94 9:13 A.M.

ROBERT W. SMITH
REGISTER OF DEEDS

1. Public Land Survey T 23 R 3 W I- 11
T _____ R _____
T _____ R _____
T _____ R _____
2. Property Controlling S _____ T _____ R _____
in Section S _____ T _____ R _____
3. Miscellaneous S _____ T _____ R _____
Property in Sec. S _____ T _____ R _____

TO BE FILED IN LIBER 3 OF LAND CORNER:

Register of Deeds Stamp & File Number

4. Lot No. _____, Recorded Plat _____
5. Private Claims _____

I, Frank J. Arleth, in a field survey on November, 19 1994,
do hereby certify that under requirements of P.A. 74, Michigan P.A. of 1970, the corner points mentioned
in lines 1 and 2 above were in conformance with regulations and rules therefore as required in the
current manual of survey instructions of the United States Department of the Interior, Bureau of Land
Management or by a decree of a Court of Law and/or that the corner points mentioned in lines 3, 4 and 5
above were in conformance with the rules of the Michigan Board of Land Surveyors or by a Decree of a
Court of Law; established, re-established, monumented, re-monumented, recovered, found as
expressed below:

**NOTE: Not more than 4 corners, all in the same town and range, may be recorded
on this certificate.**

	A	B	C	D	E	F	G	H	I	J	K	L	M
2	5		5		4		3		2		1		
3													
4	7		8		9		10		11		12		
5													
6	18		17		16		15		14		13		
7													
8	19		20		21		22		23		24		
9													
10	30		29		28		27		26		25		
11													
12	31		32		33		34		35		36		
13													

A. Description of original monument and accessories and/or subsequent restoration:

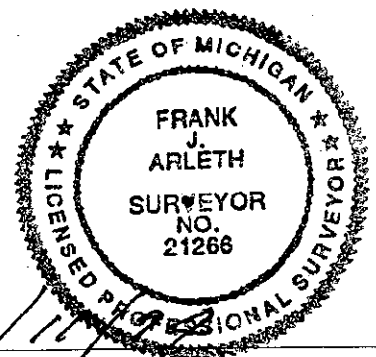
Artemas Curtis Set post 1852 1960 Ostling found $1\frac{1}{4}$ " pipe for N.E. corner of Sec. 34 which
Hemlock 14" N15°E 23 lks was used for the four plats of woodland acres.
Hemlock 14" S54°W 34 Lks 1989 Arleth set $\frac{1}{2}$ " bar & cap in $1\frac{1}{4}$ " pipe found 8" below
1941 Henning found $1\frac{1}{4}$ " iron pipe road surface. Re-wit for R.C.R.C. 1989 Witness
throughout to be set by G. F. Spike E Side of 12' Maple N45°W 56.9
Delamater Spike S side of 14" Maple N45°E 56.8
found old BT Spike W side 12" N. Pine S45°E 51.36
Blazed 10" maple N57°30'W 58.8
Blazed 6" maple S30°30'E 71.8

B. Description of corner evidence found and/or method applied in restoring or reestablishing corner:

November 1994 Arleth found $\frac{1}{2}$ " bar & cap #21266 in $1\frac{1}{4}$ " pipe 2.5' south of constructed
centerline of E & W road. Found $\frac{1}{2}$ " x 24" bars set at 90° South of corner to save
during road construction at 40 feet & 100 feet from corner.

C. Description of monument for corner and accessories established to perpetuate locating the position of the corner:

Used $1\frac{1}{4}$ " pipe with $\frac{1}{2}$ " x 24" bar in center with Cap # 21266
Corner is 2.5' South of Centerline of E & W Road
N & T 10" J. pine N40°E 44.30
N & T 6" B. Oak N6°W 64.50
N & T 10" N. pine S62°E 79.75
N & T 16" Twn Maple S23°30'W 94.30
Spike 12" Maple N49°W 64.84
Spike 14" Maple N44°E 56.73
Spike 12" N. Pine S34°E 51.34
Set carsonite post North 33.00 feet

Signed by Frank J. Arleth Date 11/10/94Surveyor's Michigan License No. 21266 P.S.DATE 11/10/94 Peer Group ApprovedFORM APPROVED BY MICHIGAN STATE BOARD OF LAND SURVEYORS, JAN. 28, 1971
REVISED MAY 14, 1975
REVISED JAN., 1983

LIBER 3 PAGE 153