

SURVEY &
REMONUMENTATION

APR 24 1995

ROSCOMMON COUNTY

PEER GROUP APPROVAL COMMISSION

DATE Dec 13, 1994

ROSCOMMON COUNTY REMONUMENTATION
LAND CORNER RECORDATION CERTIFICATE
Filing Requirement of Act 74, Mich. P.A. 1970

STATE OF MICHIGAN
ROSCOMMON COUNTY
RECORDED

16 DEC 94 2:35 P.M.

ROBERT W. SMITH
REGISTER OF DEEDS

For corners in

Roscommon
(County)

Located In:

Corner Code ##

1. Public Land Survey

T 23N R 3W

E - 7

T R

T R

T R

T R

2. Property Controlling
in Section

S T R

S T R

3. Miscellaneous

S T R

Property in Sec.

S T R

4. Lot No. , Recorded Plat

5. Private Claims

I, Marvin E. Myers, in a field survey on October 13, 19 94, do hereby certify that under requirements of P.A. 74, Michigan P.A. of 1970, the corner points mentioned in lines 1 and 2 above were in conformance with regulations and rules therefore as required in the current manual of survey instructions of the United States Department of the Interior, Bureau of Land Management or by a decree of a Court of Law and/or that the corner points mentioned in lines 3, 4 and 5 above were in conformance with the rules of the Michigan Board of Land Surveyors or by a Decree of a Court of Law; established, re-established, monumented, re-monumented, recovered, found as expressed below:

NOTE: Not more than 4 corners, all in the same town and range, may be recorded on this certificate.

A. Description of original monument and accessories and/or subsequent restoration:

GLO-Artemas Curtis 1852

Mon-Set Post

WIT: 10" Tamarack N50°E 43 lks.

14" Tamarack S80°W 34 lks.

Unknown Surveyor

Mon-½" Bar & Post

WIT: None

B. Description of corner evidence found and/or method applied in restoring or reestablishing corner:

Monument - Found ½" x 30" Bar

WIT: Found blaze and wit. tag marked "G.F. Delamater surveyor Gaylord, Mich. 1928" East face 11" Cedar N79°W 21.97' Accepted as a best available evidence of the position of the original corner.

C. Description of monument for corner and accessories established to perpetuate locating the position of the corner:

Mon-Set Std. Roscommon County Mon. stamped "T23N R3W E-7 31600"

WIT: Fd. blaze & wit. tag mkd. "G.F. Delamater surveyor Gaylord, Mich. 1928" E. face 11" Cedar N79°W 21.97'


Set wit. tag & nail SW side 15" Maple N15°W 21.38'

Set wit. tag & nail N. side 5" Cedar S68°E 13.51'

Set wit. tag & nail NW side 7" Cedar S34°W 17.38'

Set wit. tag & nail S. side 6" Cedar N70°W 17.34'

Set carsonite post S06°W 3.0'

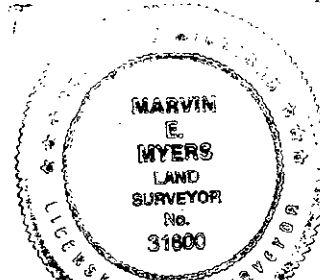

Signed by Marvin E. Myers

Date

Dec 15, 1994

Surveyor's Michigan License No. 31600