

2020

SURVEY &
REMONUMENTATION

OCT 05 1998

LAND CORNER RECORDATION CERTIFICATE
Filing Requirement of Act 74, Mich. P.A. 1970

SECTION

For corners in

Roscommon

(County)

Located In:

Corner Code #

STATE OF MICHIGAN
ROSCOMMON COUNTY
RECORDED

20 APR 98 2:18 P.M.

ROBERT W. SMITH
REGISTER OF DEEDSTo be filed in Liber 3 of Land
Corners

Register of Deeds Stamp & File Number

1. Public Land Survey

T 24N R 1W

T 23N R 1W

T R

T R

S T R

S T R

S T R

S T R

C-13

C-1

2. Property Controlling
in Section3. Miscellaneous
Property in Sec.

4. Lot No. _____, Recorded Plat _____

5. Private Claims _____

I, Marvin E. Myers, in a field survey on March 2, 1998, do hereby state that under requirements of P.A. 74, Michigan P.A. of 1970, the corner points mentioned in lines 1 and 2 above were in conformance with regulations and rules therefore as required in the current manual of survey instructions of the United States Department of the Interior, Bureau of Land Management or by a decree of a Court of Law and /or that the corner points mentioned in lines 3, 4 and 5 above were in conformance with the rules of the Michigan Board of Land Surveyors or by a Decree of a Court of Law; established, re-established, monumented, recovered, found as expressed below:

NOTE: Not more than 2 corners, all in the same town and range, may be recorded on this certificate.

A. Description of original monument and accessories and/or subsequent restoration:

G.L.O. - 1838 Lewis Clason, DS
Mon. - Post
7" Beech N59 1/2°E 30 links
8" Beech N27 1/2°W 31 links

B. Description of corner evidence found and/or method applied in restoring or reestablishing corner:

Found 1 1/2"x48" pipe broken off at ground surface.
Accepted as the best available evidence of the position of the Original Corner.
Replaced pipe with Standard Roscommon County Monument.

C. Description of monument for corner and accessories established to perpetuate locating the position of the corner:

Mon - Standard Roscommon County Monument.

Wit: Set carsonite post 1' South.

Set nail & tag in West face 4" Oak S07°E 33.14'

Set nail & tag in South face 8" White Pine N77°W 80.99'

Set nail & tag in West face 4" Oak N08°E 61.51'

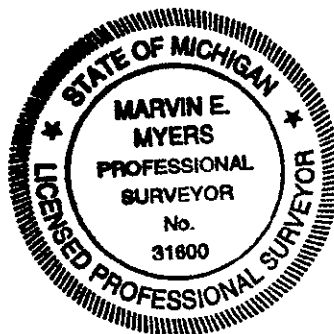
Set nail & tag in West face 5" Oak N54°E 69.39'

ROSCOMMON COUNTY
PEER GROUP APPROVAL
DATE MARCH 27th 1998

Marvin E. Myers
Marvin E. Myers, P.S.
County Surveyor

Signed by

Marvin E. Myers

Surveyor's Michigan License No. 31600Date April 10, 1998

LIBER 3 PAGE 492