

SURVEY & REMONUMENTATION

2020

OCT 05 1998

SECTION LAND CORNER RECORDATION CERTIFICATE Filing Requirement of Act 74, Mich. P.A. 1970

STATE OF MICHIGAN
ROSCOMMON COUNTY
RECORDED

For corners in

20 APR 98 2:19 P.M.

Roscommon

(County)

Located In:

Corner Code #

1. Public Land Survey

T 24N R 1W

T 23N R 1W

T R

T R

2. Property Controlling
in Section

S T R

S T R

3. Miscellaneous

S T R

Property in Sec.

S T R

4. Lot No. _____, Recorded Plat _____

5. Private Claims _____

I, Marvin E. Myers, in a field survey on March 2, 1998 do hereby state that under requirements of P.A. 74, Michigan P.A. of 1970, the corner points mentioned in lines 1 and 2 above were in conformance with regulations and rules therefore as required in the current manual of survey instructions of the United States Department of the Interior, Bureau of Land Management or by a decree of a Court of Law and /or that the corner points mentioned in lines 3, 4 and 5 above were in conformance with the rules of the Michigan Board of Land Surveyors or by a Decree of a Court of Law; established, re-established, monumented, recovered, found as expressed below:

NOTE: Not more than 2 corners, all in the same town and range, may be recorded on this certificate.

A. Description of original monument and accessories and/or subsequent restoration:

L-13 G.L.O. - 1838 Lewis Clason, DS
Mon. - Post
5" S. Pine N72°E 55 lks.
5" Aspen N15°E 53 lks

Department of Conservation, Marcus Schaaf 1900's
Found or established, and replaced

ROSCOMMON COUNTY

PEER GROUP APPROVAL

DATE MARCH 27, 1998

Marvin E. Myers

Marvin E. Myers, P.S.
County Surveyor


B. Description of corner evidence found and/or method applied in restoring or reestablishing corner:

Found 1 1/4" IP in set in concrete typical of Schaaf in centerline of old East - West road bed and in line with tree line South, monument is 230± South of existing centerline of Mari Lake Road. Accepted as a perpetuation of the Original government Corner. Replaced Schaaf monument with Standard Roscommon County monument.

C. Description of monument for corner and accessories established to perpetuate locating the position of the corner:

Mon - Standard Roscommon County monument.

Wit: Set nail and tag in East face 8" Jack Pine S34°W 16.44'
Set nail and tag in East face 8" Jack Pine N32°W 4.40'
Set nail and tag in North face 6" Jack Pine N56°W 15.74'
Set nail and tag in North face 6" Poplar S63°E 23.31'
Set carsonite post 1' South.

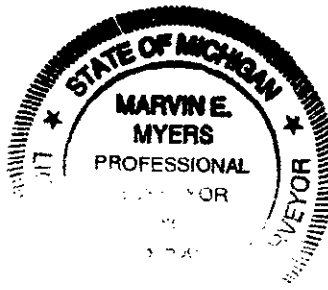

Signed by

Marvin E. Myers

Date April 10, 1998

Surveyor's Michigan License No. 31600

LIBER 3 PAGE 502