

7868

STATE OF MICHIGAN  
ROSCOMMON COUNTY  
RECORDED

## LAND CORNER RECORDATION CERTIFICATE

Filing Requirement of Act 74, Mich. P.A. 1970

30 OCT 97 12:29 P.M.

For corners in  
Roscommon  
(County)

Located In:

Corner Code #

ROBERT W. SMITH  
REGISTER OF DEEDS

1. Public Land Survey T 24N R 1W C - 7  
 T \_\_\_\_\_ R \_\_\_\_\_  
 T \_\_\_\_\_ R \_\_\_\_\_  
 T \_\_\_\_\_ R \_\_\_\_\_  
 T \_\_\_\_\_ R \_\_\_\_\_
2. Property Controlling S \_\_\_\_\_ T \_\_\_\_\_ R \_\_\_\_\_  
 in Section S \_\_\_\_\_ T \_\_\_\_\_ R \_\_\_\_\_  
 3. Miscellaneous S \_\_\_\_\_ T \_\_\_\_\_ R \_\_\_\_\_  
 Property in Section S \_\_\_\_\_ T \_\_\_\_\_ R \_\_\_\_\_

FILE IN LIBER 3 OF LAND CORNERS  
Register of Deeds Stamp & File Number

4. Lot No. \_\_\_\_\_, Recorded Plat \_\_\_\_\_  
 5. Private Claims \_\_\_\_\_

I, Marvin E. Myers, in a field survey on August, 19 97,  
 do hereby certify that under requirements of P.A. 74, Michigan P.A. of 1970, the corner points mentioned  
 in lines 1 and 2 above were in conformance with regulations and rules therefore as required in the current  
 manual of survey instructions of the United States Department of the Interior, Bureau of Land  
 Management or by a decree of a Court of Law and/or that the corner points mentioned in lines 3, 4 and  
 5 above were in conformance with the rules of the Michigan Board of Professional Surveyors or by a  
 Decree of a Court of Law; established, re-established, monumented, re-monumented, recovered, found  
 as expressed below:

**NOTE: Not more than 4 corners, all in the same town and range, may be recorded  
 on this certificate.**

## A. Description of original monument and accessories and/or subsequent restoration:

GLO - 1852 Wm. Burt, D.S.

LCRC Liber 1, pg. 15 J. Wilcox, PS. #14102

Mon. - Post

Mon. - Fd.  $\frac{1}{2}$ " rerod & cap

WIT: 20" Y.Pine N43°E 23 lks.

WIT: 16" Red Oak S68°E 83.05'

12" Y.Pine S62 $\frac{1}{2}$ °W 8 lks.

8" Red Oak N78°E 34.54'

16" Y.Pine S87°46'E 193 lks.

12" Maple N33°E 22.60'

16 " Y.Pine N87°46'W 310 lks.

8" Red Oak N20°W 39.20'

SURVEY &  
REMONUMENTATION

APR 07 1998

SECTION

## B. Description of corner evidence found and/or method applied in restoring or reestablishing corner:

Found  $\frac{1}{2}$ " bar & cap (cap not legible) centerline trail 6' South

Found 16" Red Oak Blaze S72°E 82.64'

Found 12" Red Oak Blaze N74°E 34.88'

Found 14" Maple Blaze N30°E 22.51'

Found 12" Red Oak Blaze N24°W 39.11'

Replaced  $\frac{1}{2}$ " bar & cap with standard Roscommon County MonumentAccepted position as the best available evidence of the position of the  
original cornerROSCOMMON COUNTY  
PEER GROUP APPROVAL  
DATE Oct 2, 1997 MEM

## C. Description of monument for corner and accessories established to perpetuate locating the position of the corner:


Set standard Roscommon County monument

WIT: Nail &amp; tag in 16" Red Oak S72°E 82.65'

Nail &amp; tag in 12" Red Oak N74°E 34.05'

Nail &amp; tag in 14" Maple N30°E 22.53'

Nail &amp; tag in 12" Red Oak N24°W 39.16'

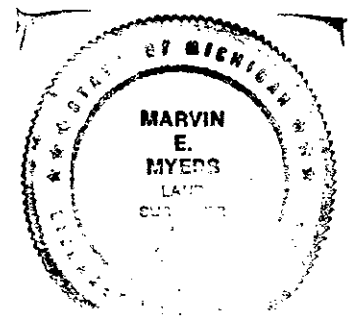

Signed by

Date Oct. 24, 1997Surveyor's Michigan License No. 31600FORM APPROVED BY MICHIGAN STATE BOARD OF PROFESSIONAL SURVEYORS, JAN. 28, 1971  
REVISED MAY 14, 1975  
REVISED JAN., 1983

LIBER 3 PAGE 425