

APR 07 1998

7871

LAND CORNER RECORDATION CERTIFICATE
Filing Requirement of Act 74, Mich. P.A. 1970

SECTION

For corners in
Roscommon
(County)

Located in:

Corner Code #

- | | | | | | |
|-------------------------|---|------------|---|-----------|--------------|
| 1. Public Land Survey | T | <u>24N</u> | R | <u>1W</u> | <u>F - 7</u> |
| | T | | R | | |
| | T | | R | | |
| | T | | R | | |
| 2. Property Controlling | S | | T | | |
| in Section | S | | T | | |
| 3. Miscellaneous | S | | T | | |
| Property in Section | S | | T | | |

STATE OF MICHIGAN
ROSCOMMON COUNTY
RECORDED

30 OCT 97 12:29 P.M.

ROBERT W. SKITH
REGISTER OF DEEDS
FILE IN LIBER 3 OF LAND CORNERS
Register of Deeds Stamp & File Number

4. Lot No. _____, Recorded Plat _____
5. Private Claims _____

I, Marvin E. Myers, in a field survey on _____, 19____
do hereby certify that under requirements of P.A. 74, Michigan P.A. of 1970, the corner points mentioned
in lines 1 and 2 above were in conformance with regulations and rules therefore as required in the current
manual of survey instructions of the United States Department of the Interior, Bureau of Land
Management or by a decree of a Court of Law and/or that the corner points mentioned in lines 3, 4 and
5 above were in conformance with the rules of the Michigan Board of Professional Surveyors or by a
Decree of a Court of Law; established, re-established, monumented, re-monumented, recovered, found
as expressed below:

**NOTE: Not more than 4 corners, all in the same town and range, may be recorded
on this certificate.**


	A	B	C	D	E	F	G	H	I	J	K	L	M
2	6		5		4		3		2		1		
3													
4	7		8		9		10		11		12		
5													
6	18		17		16		15		14		13		
7													
8	19		20		21		22		23		24		
9													
10	30		29		28		27		26		25		
11													
12	31		32		33		34		35		36		

- A. Description of original monument and accessories and/or subsequent restoration:
- | | |
|----------------------------------|--|
| GLO - 1852 Wm. Burt, D.S. | L. 1, pg. 219 LCRC Oct. 1981 J. Wilcox, PS 14102 |
| Mon. - Post | Mon. - Round concrete mon. as established |
| WIT: 12" Cedar S87°46'E 131 lks. | by G.F. Delamater |
| 10" B.Ash S04°W 12 lks. | WIT: 4" B.Ash N46°E 13.76' |
| 4" Cedar N09½°E 8 lks. | 6" B.Ash N09°W 18.19' |
| 5" Cedar N87°46'W 282 lks. | 4" W.Birch S04°E 11.94' |
| | 4" B.Ash S27°E 19.57' |

- B. Description of corner evidence found and/or method applied in restoring or reestablishing corner:
- Found concrete monument 4"x4' replaced with standard Roscommon County monument
Blaze & nail in 6" B.Ash AZ 363° 8.10'
Blaze & nail in 4" B.Ash AZ 48° 13.72'
Accepted as the best available evidence of the position of the original government corner

ROSCOMMON COUNTY
PEER GROUP APPROVAL
DATE Oct 22, 1997 *MEM*

- C. Description of monument for corner and accessories established to perpetuate locating the position of the corner:
- Set Roscommon County Monument
WIT: Blaze & nail in 6" B.Ash 8.10' AZ 353°
Blaze & nail in 4" B.Ash 13.72' AZ 48°
Nail & tag in 4" B.Ash 15.50' AZ 125°
Nail & tag in 7" B.Ash 18.61' AZ 299°

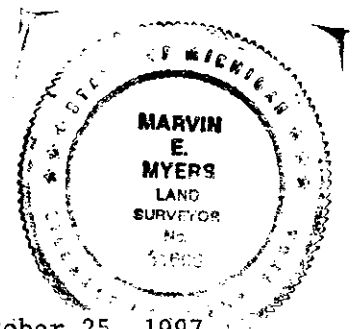

Signed by *Marvin E. Myers*
Surveyor's Michigan License No. 21600

Date October 25, 1997
FORM APPROVED BY MICHIGAN STATE BOARD OF PROFESSIONAL SURVEYORS, JAN. 28, 1971
REVISED MAY 14, 1975
REVISED JAN., 1983