

9388

ROSCOMMON COUNTY
PEER GROUP APPROVAL
DATE 11-29-94
mm

ROSCOMMON COUNTY REMONUMENTATION
LAND CORNER RECORDATION CERTIFICATE
 Filing Requirement of Act 74, Mich. P.A. 1970

JAN 24 1996

COMMISSION

For corners in
 ROSCOMMON
 (County)

Located In:

Corner Code #

TO BE FILED IN LIBER 3 OF LAND CORNER

1. Public Land Survey T 24NR 1W I-9
 T R SURVEY &
 T R REMONUMENTATION
 T R
 2. Property Controlling S T R
 in Section S T R APR 05 1996
 3. Miscellaneous S T R
 Property in Sec. S T R COMMISSION

STATE OF MICHIGAN
 ROSCOMMON COUNTY
 RECORDED

28 DEC 94 1:05 P.M.

ROBERT W. SMITH
 Register of Deeds State & File Number

4. Lot No. _____, Recorded Plat _____
 5. Private Claims _____


I, Timothy L. Lapham, in a field survey on June, 19 94,
 do hereby certify that under requirements of P.A. 74, Michigan P.A. of 1970, the corner points mentioned
 in lines 1 and 2 above were in conformance with regulations and rules therefore as required in the
 current manual of survey instructions of the United States Department of the Interior, Bureau of Land
 Management or by a decree of a Court of Law and/or that the corner points mentioned in lines 3, 4 and 5
 above were in conformance with the rules of the Michigan Board of Land Surveyors or by a Decree of a
 Court of Law; established, re-established, monumented, re-monumented, recovered, found as
 expressed below:

**NOTE: Not more than 4 corners, all in the same town and range, may be recorded
 on this certificate.**

A. Description of original monument and accessories and/or subsequent restoration:
 I-9: 1852, BURT, POST, W. PINE 8" NORTH 10 LKS, TAMARACK 8" S76W 22 LKS;
 NO RECORDED SURVEYS;
 NO L.C.R.C.

B. Description of corner evidence found and/or method applied in restoring or reestablishing corner:
 I-9: FOUND 1/2" X 18" REBAR IN MONUMENT BOX, EXCAVATED TO 3 FEET AND FOUND NO FURTHER EVIDENCE;
 FOUND NO EVIDENCE OF GLO; MEASURED NORTH 2652.50' TO 1/4 COR, FOUND 1/8 CORNER ON LINE AT
 1326.25'; CORNER FITS EXISTING VISIBLE OCCUPATION LINES EAST AND WEST. FOUND CAPPED IRON
 33.0' WEST;
 ACCEPTED FOUND CORNER AS BEST AVAILABLE EVIDENCE OF THE LOCATION OF THE ORIGINAL CORNER.
 THIS CORNER ESTABLISHED IN ACCORDENCE WITH THE ROSCOMMON COUNTY REMONUMENTATION PROGRAM.
 SEE DOSSIER FOR DETAILED REPORT.
 THIS CORNER APPROVED AT A PEER REVIEW MEETING HELD ON NOVEMBER 29, 1994.

C. Description of monument for corner and accessories established to perpetuate locating the position of the corner:
 I-9: SET A 2 1/2" X 24" CAST IRON MONUMENT, 4" BELOW SURFACE OF ASPHALT IN MONUMENT BOX WITH
 BRASS DISK MARKED "ROSCOMMON COUNTY, 1994 27595";
 S70E 31.62' NAIL & TAG IN POWER POLE
 S24E 63.59' NAIL & TAG IN 30" WILLOW
 S12E 101.33' NAIL & TAG IN 30" WILLOW
 WEST 58.42' NAIL & TAG IN POWER POLE

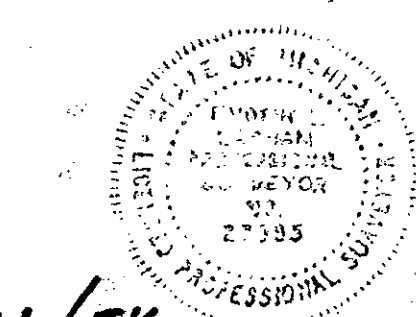

Signed by

Date

12/22/94

Surveyor's Michigan License No. 27595