LAND CORNER RECORDATION CERTIFICATE

STATE OF HICHIGAN ROSCONNON COUNTY

and and another	RECORDED	
Located In:	Corner Code #	6 MAY 99 2:10 P.M.
T 24N & 2M		ROBERT W. SMITH REGISTER OF DEEDS
	_	Conner Code #

2. Property Controlling in Section 3. Miscellaneous R Property in Sec.


To be filed in Liber 3 of Land Corners

Register of Deeds Stamp & File Number

4.	Lot No	Recorded F	Plat	
5.	Private Claims			

1, Marvin E. Myers , in a field survey on _Merch , 1999 do hereby state that under requirements of P.A. 74, Michigan P.A. of 1970, the corner points mentioned in lines 1 and 2 above were in conformance with regulations and rules therefore as required in the current manual of survey instructions of the United States Department of the Interior, Bureau of Land Management or by a decree of a Court of Law and /or that the comer points mentioned in lines 3, 4 and 5 above were in conformance with the rules of the Michigan Board of Land Surveyors or by a Decree of a Court of Law, established, re-established, monumented, recovered, found as expressed below:

NOTE: Not more than 2 corners, all in the same town and range, may be recorded on this certificate.

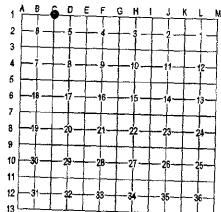

Description of original monument and accessories and/or subsequent restoration:

G.L.O - 1838 John Brink D.S.

George D. Henning R.L.S.

Unrecorded survey December 1941

Mon. - Post

Mon: 1/2 buggy axie set in 1937 from the stumps of the original U.S. BT's, Position verified from

10* Pitch Pine N78°W 37 links. chainage from North, East, and West.

10° Pitch Pine N51 1/2°E 26 links

Wit: 16" Norway Pine N82°E 104.61" 6" Jack Pine N65°W 31.4"

10" Jack Pine S42°W 21.1" OF MICHGAMIN

George D. Henning R.L.S.

Unrecorded survey February, 1942

Mon: 1/2 buggy ade

Wit: 16" Norway Pine N82°E 1.16 1/2

10" Jack Pine \$42°W 32


6" Jack Pine N65°W 47 1/2

14" White Pine S72 1/2°E 1.58 1/2

Plat of Johnston Acres by G. D. Henning Rescommon County Records, 1954 Mon: 1" x 1" x 36" iron in corner

Wit: 16" Yellow Pine N82°E 76.9"

14" White Pine S72 1/2°E 104.6"

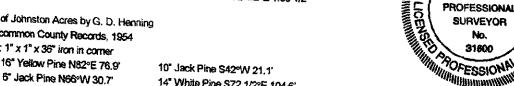

B. Description of corner evidence found and/or method applied in restoring or reestablishing corner: Found 1" x 1" x 36" iron (buggy axle)

Found 16" Yellow Pine N82°E 76.9"

Found 10" Jack Pine S42°W 21.1'

Found 6" Jack Pine N66°W 30.7"

Found 14" White Pine \$72 1/2°E 104.6"

Accepted 1" iron buggy axle as a perpetuation of the Original Government Corner. Replaced 1" iron with Standard Rescommon County monument.

C. Description of monument for corner and accessories established to perpetuate locating the position of the corner: Mon: Standard Roscommon County Corner

Wit: Set nail & tag in 12" White Pine S72°E 48.86" Set nail & tag in 16" Black Oak S53°W 31.92'

Set nail & tag in Power Pole S08°E 51.78'

Set Carsonite Post N42°W 25.98'

STATE OF MICHIGA

MARVIN E

MYERS

Surveyor's Michigan License No. 31600
PEER GROUP APPROVAL

FORM APPROVED BY MICHIGAN STATE BOARD OF PROFESSIONAL SURVEYORS, JAN. 28, 1971 REVISED MAY 14, 1975 REVISED JAN., 1983 REVISED OCT., 1996

County Surveyor

LIBER 3 PAGE 597

DATE April 19, 1999

marin E. Myen News Marvin E. Myers, P.S.